MISSISSIPPI DEPARTMENT OF ENVIRONMENTAL QUALITY
Office of Land and Water Resources

P. O. Box 10631
Jackson, MS 39289-0631
WATER WELL DRILLERS LOG

COUNTY WELL LOCATED	Marion
WELL NUMBER	G-2052
CODED	
DATE WELL COMPLETED	7-27-99
PERMIT NUMBER	O-586
NAME OF DRILLING FIRM	James Wells Water Well Ser.

NAME & MAILING ADDRESS OF LANDOWNER
W. A. Bond
1982 National Guard Rd.
Columbia Ms. 39429

WELL LOCATION: SEC 35 TOWNSHIP 4 (N) S RANGE 18 (E) W

DISTANCE 3 Miles DIRECTION EAST of NEAREST TOWN Columbia

OTHER LANDMARK

WELL PURPOSE: Home, Irrigation, Municipal, Industrial, Fish Pond, etc.

PUMP DATA

PUMP TYPE (Circle One): Submersible, Turbine, Jet Flowing Well, Other (Describe)

POWER TYPE (Circle One): Electric, Tractor, Diesel, Gasoline, Butane, Other (Describe) H/P 2

Pump Capacity (GPM)	No. of Stages	Setting Depth
		FT.

PUMP TEST
Well yielded 25 GPM with a drawdown of ft. after hours of pumping

WELL DATA

Well Depth	Casing Diameter (In.)	Casing Length (Ft.)
160	4	140
Type of Casing	**Hole Depth**	**Depth to Static Water Level**
PVC	160	110

TYPE OF COMPLETION: (Circle One or More): Gravel Packed, Underreamed, Telescoped, Natural Development, Open Hole, Other (Describe)

WELL GROUTED TO A DEPTH OF 18 FEET
Type Grout (circle one): Cement, Bentonite, or Mix

LOG DATA

TYPE OF LOG RUN (Circle One): No Log Run, Electric, Gamma Ray, Density, Sonic, Neutron, Other (Describe)

Name of Organization Running Log

GEOLOGIC DATA (Office Use Only)

Surface Elev.	Geologic Unit	Unit Thickness	Depth to Top
Subs. SWL	Date	Analysis	Aquifer Test

Driller's Remarks

SCREEN DATA

Diameter - Inches	Length - Feet	Slot Size - Inches
4	20	80
Screen Type		**Depth to Bottom - Feet**
PVC		140-160

Top of Lap Pipe or Reduction in Casing FEET

IF TELESCOPED OR MORE THAN ONE SCREEN: USE BACK PAGE

RECEIVED JUL 13 2000 Dept. of Environmental Quality Office of Land & Water Resources

DESCRIPTION OF FORMATIONS ENCOUNTERED	FROM	TO
Top Soil	0	2
Sand	2	10
Clay	10	80
Gravel	80	130
Sand	130	160

FORMATIONS (Continued)	FROM	TO

IF MORE SPACE IS NEEDED, USE BACK

If well telescopes please
sketch and show depths.

GROUND LEVEL

 

If more than one screen,
show location of each on sketch.

SECTION _____

Please indicate well location X.

ADDITIONAL INFORMATION