Marion
H5
7-5-70

MISSISSIPPI
BOARD OF WATER COMMISSIONERS
416 North State Street
Jackson, Mississippi 39201

CODED

# WATER WELL DRILLERS LOG

7-5 1970 Griner Drilling Service MARION
date well completed — firm name — county well located

LANDOWNER: HWY 98
East Water Ass'n.
Columbia, Miss.
(mailing address)

WELL LOCATION:
sec. 32 T 4N (S) R 17W (E)
4 (distance) miles E (direction) of Columbia (nearest town)

WELL PURPOSE: Municipal
(home, irrigation, municipal, industrial)

WELL COMPLETION DATA:
(1) diameter (inches) 6"
(2) total depth (feet) 960'
(3) static water level (feet) 165' below above top of ground.
(4) casing Steel (material), 910' (depth),
6 (size) if telescope see back.
(5) screen 40' (length), 920' (depth to top)
.010 4" (size), S.S. (material)
(6) pump 15 (HP) 150 (yield gpm)
Elec. (type power)
(7) electric log yes (yes or no)
U.S. E.S. (organization running log)
(8) how well bottom plugged Back Wash Valve

DRILLERS REMARKS:

| description of formations encountered | from | to |
|---|---|---|
| Top Soil | 0 | 2 |
| Clay | 2 | 27 |
| Sand | 27 | 148 |
| Clay | 148 | 200 |
| Sand | 200 | 306 |
| Clay | 306 | 452 |
| Sand | 45 | 520 |
| Clay | 520 | 550 |
| Sand | 550 | 754 |
| Clay | 754 | 892 |
| Sand | 892 | 969 |

JUL 10 1970
MISS. BD. OF

If well telescopes please sketch and show depths.

GROUND LEVEL

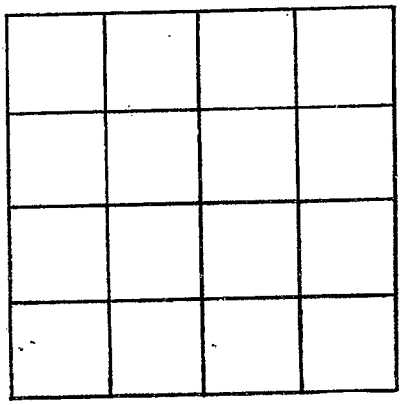

SECTION _____

Please indicate well location X.

ADDITIONAL INFORMATION

If more than one screen, show locations of each on sketch.