MISSISSIPPI DEPARTMENT OF ENVIRONMENTAL QUALITY
Office of Land and Water Resources

P. O. Box 10631
Jackson, MS 39289-0631
WATER WELL DRILLERS LOG

COUNTY WELL LOCATED: Marion	
WELL NUMBER: H-2035	CODED:
DATE WELL COMPLETED: 5-31-2000	
PERMIT NUMBER: 0-5-86	
NAME OF DRILLING FIRM: James Wells Water Wells Inc.	

NAME & MAILING ADDRESS OF LANDOWNER
Ray Regan
2756 Hwy 44
Hy 44
Columbia MS 39429

WELL LOCATION	SEC	TOWNSHIP	RANGE
	19	4 S (N)	17 E (W)

DISTANCE	DIRECTION	NEAREST TOWN
6 Miles	EAST of	Columbia

OTHER LANDMARK: Hy 44

WELL PURPOSE: Home, Irrigation, Municipal, Industrial, Fish Pond, etc.

PUMP DATA

PUMP TYPE (Circle One): Submersible, Turbine, Jet, Flowing Well, Other (Describe) _____

POWER TYPE (Circle One): Electric, Tractor, Diesel, Gasoline, Butane, Other (Describe) _____ H/P 1

Pump Capacity (GPM)	No of Stages	Setting Depth
		FT.

PUMP TEST

Well yielded 15 GPM with a drawdown of _____ ft. after _____ hours of pumping

WELL DATA

Well Depth	Casing Diameter (In.)	Casing Length (Ft.)
95	4	75

Type of Casing	Hole Depth	Depth to Static Water Level
PVC	95	50

TYPE OF COMPLETION: (Circle One or More): Gravel Packed, Underreamed, Telescoped, Natural Development, Open Hole, Other (Describe) _____

WELL GROUTED TO A DEPTH OF 15 FEET
Type Grout (circle one): Cement, Bentonite, or Mix

LOG DATA

TYPE OF LOG RUN (Circle One): No Log Run, Electric, Gamma Ray, Density, Sonic, Neutron, Other (Describe) _____

Name of Organization Running Log

GEOLOGIC DATA (Office Use Only)

Surface Elev.	Geologic Unit	Unit Thickness	Depth to Top
Subs. SWL	Date	Analysis	Aquifer Test

Driller's Remarks

SCREEN DATA

Diameter - Inches	Length - Feet	Slot Size - Inches
4	20	8 00

Screen Type	Depth to Bottom - Feet
PVC	75-95

Top of Lap Pipe or Reduction in Casing: FEET

IF TELESCOPED OR MORE THAN ONE SCREEN: USE BACK PAGE

DESCRIPTION OF FORMATIONS ENCOUNTERED	FROM	TO
Top Soil	0	3
Red Clay	3	50
Sand	50	95

FORMATIONS (Continued) FROM TO

RECEIVED
JUL 20 2000
Dept. of Environmental Quality
Office of Land & Water Resources

IF MORE SPACE IS NEEDED, USE BACK

If well telescopes please
sketch and show depths.

GROUND LEVEL

 

If more than one screen,
show location of each on sketch.

SECTION _____

Please indicate well location X.

ADDITIONAL INFORMATION