

CODED

L 29  
3-18-62

WATER WELL DRILLERS LOG

Date: 3-18, 1962, Driller: [Signature] County Marion  
(Name)

(1) Owner of Land: Mr. Charles Perkins  
(Name)

Columbine Miss  
(Address)

(2) Location: 10 3 18  
1 miles of [direction], of [Nearest Town]  
(distance) (direction) (Nearest Town)

(3) Topography: [Hilly] (Hilly) [Flat] (Flat) [Level] (Level)

(4) Purpose of Well: Domestic  
(Domestic Irrigation  
Municipal, Industrial, Other)

Information upon completion of well:

(1) Diameter 4 inches.

(2) Total Depth 86 feet.

(3) Water Level 60 feet below top of ground.

(4) Cased to 80, Size 4

(5) Screen: Size 4, Length 60 feet

(6) Were any formations sealed against pollution?

no yes, no no.

If YES depth of formation \_\_\_\_\_

Why \_\_\_\_\_

Drillers Remarks: \_\_\_\_\_


Description & Color of Materials  
Sand, Clay, Red Clay, Shell, etc.

Thick-  
ness  
Feet

Depth  
Feet

60 ft. sand  
26 ft. water sand

CODED

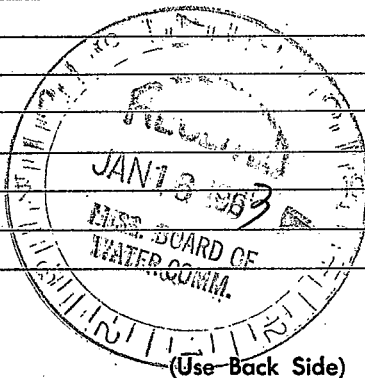

(Use Back Side)

Well No.






