MARION
M84
1-4-74

MISSISSIPPI
BOARD OF WATER COMMISSIONERS
416 North State Street
Jackson, Mississippi 39201

WATER WELL DRILLERS LOG

CODED

1-4 1974 [redacted] Marion
date well completed firm name county well located

LANDOWNER:
Otis P. Bullock
Rt. 6, Box 269 Columbia, Miss.
(mailing address)

WELL LOCATION:
sec. 17 T 3 (N) (S) R 17 (E) (W)
7½ miles S.E. of Columbia
(distance) (direction) (nearest town)

WELL PURPOSE: Home
(home, irrigation, municipal, industrial)

WELL COMPLETION DATA:

(1) diameter (inches) 2"

(2) total depth (feet) 110

(3) static water level (feet) 50 below above top of ground.

(4) casing plastic (material), 100 (depth),
2" (size) if telescope see back.

(5) screen 10 (length), 100 (depth to top)
2" (size), plastic (material)

(6) pump 3/4 (HP) 10 (yield gpm)
elec (type power)

(7) electric log NO (yes or no)
NO (organization running log)

(8) how well bottom plugged B.W. Valve

DRILLERS REMARKS:

description of formations encountered	from	to
Top Soil	0	2
Clay	2	18
Sand & Gravel	18	56
Clay	56	78
Sand	78	110

CODED

If well telescopes please sketch and show depths.

GROUND LEVEL

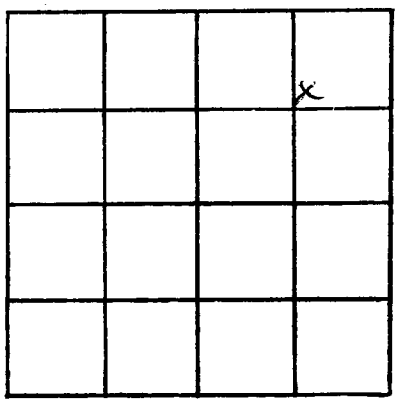

SECTION 17

Please indicate well location X.

ADDITIONAL INFORMATION

If more than one screen, show locations of each on sketch.