Marion
N 2033

6-19-79
6-19 19

date well completed

MISSISSIPPI
BOARD OF WATER COMMISSIONERS
416 North State Street
Jackson, Mississippi 39201

WATER WELL DRILLERS LOG
TOM GRIFFITH
PLUMBING & WELL SERVICE, INC.
firm name

Marion
county well located

LANDOWNER: Mrs. Clarence Varnado
Box 366 - Foxworth, Miss. 13
(mailing address)

WELL LOCATION:
sec. 6 T 2 (N) (S) R 19 (E) (W)
6 miles SW of Columbia
(distance) (direction) (nearest town)

WELL PURPOSE: Home
(home, irrigation, municipal, industrial)

WELL COMPLETION DATA:

(1) diameter (inches) 2"
(2) total depth (feet) 40 ft.
(3) static water level (feet) 10 ft. below above top of ground.
(4) casing Plastic 30 ft.
(material) (depth)
2" (size) If telescope see back.
(5) screen 10 ft. 30 ft.
(length) (depth to top)
2" Plastic
(size) (material)
(6) pump 1/2 H.P. 10 gals.
(HP) (yield gpm)
Electric
(type power)
(7) electric log No
(yes or no)

(organization running log)

(8) how well bottom plugged
Back Wash Valve

DRILLERS REMARKS:

description of formations encountered	from	to
Top Soil	0	1
Sand	1	8
Gravel	8	14
Clay	14	19
Sand	19	40

Rec'd 9/21/79
Dur - L.W.

If well telescopes please sketch and show depths.

GROUND LEVEL

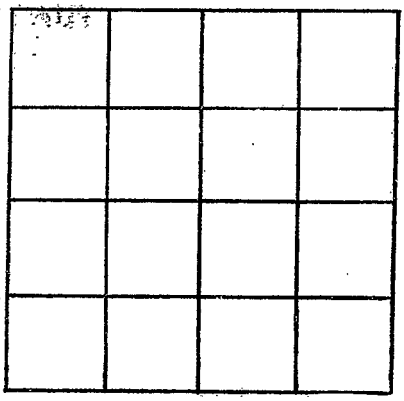

SECTION _____

Please indicate well location X.

ADDITIONAL INFORMATION

If more than one screen, show locations of each on sketch.