Marion
N 2039

5-7-80

MISSISSIPPI
BOARD OF WATER COMMISSIONERS
416 North State Street
Jackson, Mississippi 39201

WATER WELL DRILLERS LOG

May 7 1980 Reeves Well Ser Marion
date well completed — firm name — county well located

LANDOWNER: Mrs. Carrie Stringer
Rt 3 Box 94R - Foxworth
(mailing address)

WELL LOCATION:
sec. 32 T 2 N R 13 E
10 miles South of Foxworth
(distance) (direction) (nearest town)

WELL PURPOSE: house
(home, irrigation, municipal, industrial)

WELL COMPLETION DATA:

(1) diameter (inches) 4"

(2) total depth (feet) 91

(3) static water level (feet) 35 ~~below~~ above top of ground.

(4) casing Plastic bottom
(material) (depth)

— if telescope see back.
(size)

(5) screen 5' bottom
(length) (depth to top)
4" Plastic
(size) (material)

(6) pump ½ Jet 10
(HP) (yield gpm)
elect
(type power)

(7) electric log no
(yes or no)

—
(organization running log)

(8) how well bottom plugged
bad well Valve

DRILLERS REMARKS: —

description of formations encountered	from	to
Clay	0	7
Yellow Sand	7	68
Sand & pea gravel	68	91

DEPT. OF NATURAL RESOURCES
BUREAU OF LAND & WATER RESOURCES
FEB 2 - 1981
RECEIVED

If well telescopes please sketch and show depths.

GROUND LEVEL

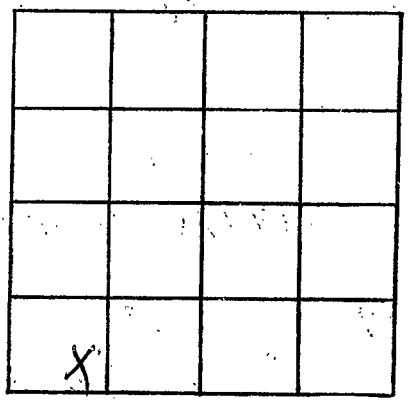

SECTION 32

Please indicate well location X.

ADDITIONAL INFORMATION

If more than one screen, show locations of each on sketch.