MISSISSIPPI DEPARTMENT OF ENVIRONMENTAL QUALITY
Office of Land and Water Resources

P. O. Box 10631
Jackson, MS 39289-0631
WATER WELL DRILLERS LOG

COUNTY WELL LOCATED	Marion
WELL NUMBER	N-2094
CODED	
DATE WELL COMPLETED	8-2-2000
PERMIT NUMBER	0-586
NAME OF DRILLING FIRM	James Wells Water Well Service

NAME & MAILING ADDRESS OF LANDOWNER
Shirlie Ard
250 Forbes Rd
Sandy Hook MS 39478

WELL LOCATION	SEC	TOWNSHIP	RANGE
	1	1 N/S	13 E/W

DISTANCE	DIRECTION	NEAREST TOWN
16 Miles	South of	Foxworth

OTHER LANDMARK

WELL PURPOSE: Home, Irrigation, Municipal, Industrial, Fish Pond, etc.

PUMP DATA

PUMP TYPE (Circle One): Submersible, Turbine, Jet, Flowing Well, Other (Describe) _____

POWER TYPE (Circle One): Electric, Tractor, Diesel, Gasoline, Butane, Other (Describe) _____ H/P _____

Pump Capacity (GPM)	No of Stages	Setting Depth
		FT.

PUMP TEST
Well yielded 15 GPM with a drawdown of _____ ft. after _____ hours of pumping

WELL DATA

Well Depth	Casing Diameter (In)	Casing Length (Ft)
160	4	140

Type of Casing	Hole Depth	Depth to Static Water Level
PVC	160	105

TYPE OF COMPLETION: (Circle One or More): Gravel Packed, Underreamed, Telescoped, Natural Development, Open Hole, Other (Describe) _____

WELL GROUTED TO A DEPTH OF 15 FEET
Type Grout (circle one): Cement, Bentonite, or Mix

LOG DATA

TYPE OF LOG RUN (Circle One): No Log Run, Electric, Gamma Ray, Density, Sonic, Neutron, Other (Describe) _____

Name of Organization Running Log

GEOLOGIC DATA (Office Use Only)

Surface Elev	Geologic Unit	Unit Thickness	Depth to Top
Subs. SWL	Date	Analysis	Aquifer Test

Driller's Remarks

SCREEN DATA

Diameter - Inches	Length - Feet	Slot Size - Inches
4	20	008

Screen Type	Depth to Bottom - Feet
PVC	140-160

Top of Lap Pipe or Reduction in Casing
FEET — IF TELESCOPED OR MORE THAN ONE SCREEN: USE BACK PAGE

DESCRIPTION OF FORMATIONS ENCOUNTERED	FROM	TO	FORMATIONS (Continued)	FROM	TO
Top Soil	0	2			
Red Clay	2	20	Casing		
Red Sand	20	90			
Clay	90	100	Cement		
Gravel	100	160			
			IF MORE SPACE IS NEEDED, USE BACK		

RECD JUL 25 2001

If well telescopes please sketch and show depths.

GROUND LEVEL

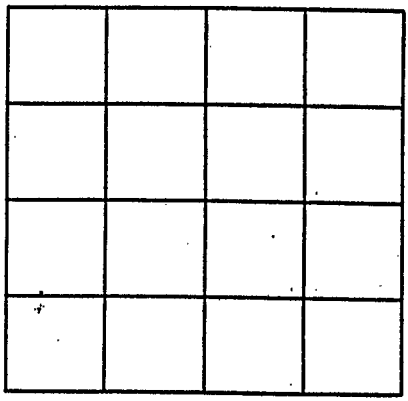

SECTION _____

Please indicate well location X.

ADDITIONAL INFORMATION

If more than one screen,