MISSISSIPPI DEPARTMENT OF ENVIRONMENTAL QUALITY
Office of Land and Water Resources

P. O. Box 10631
Jackson, MS 39289-0631
WATER WELL DRILLERS LOG

COUNTY WELL LOCATED: Marion	PERMIT NUMBER: O-586
WELL NUMBER: 9 — CODED: 2-33	NAME OF DRILLING FIRM: James Wells Water Well Ser.
DATE WELL COMPLETED: 5-13-96	

NAME & MAILING ADDRESS OF LANDOWNER
Morphis Bros. Inc.
P.O. Box 169
Trout, La. 71571

WELL LOCATION: SEC 13 TOWNSHIP 2 (N) S RANGE 18 E (W)

DISTANCE 4 Miles DIRECTION South of NEAREST TOWN Fox Worth

OTHER LANDMARK

WELL PURPOSE: Home, Irrigation, Municipal, (Industrial), Fish Pond, etc.

PUMP DATA

PUMP TYPE (Circle One): (Submersible), Turbine, Jet, Flowing Well, Other (Describe)

POWER TYPE (Circle One): (Electric), Tractor, Diesel, Gasoline, Butane, Other (Describe) H/P 5

Pump Capacity (GPM)	No. of Stages	Setting Depth
		FT.

PUMP TEST

Well yielded 100 GPM with a drawdown of ft. after hours of pumping

WELL DATA

Well Depth	Casing Diameter (In.)	Casing Length (Ft.)
100 FT	4	70

Type of Casing	Hole Depth	Depth to Static Water Level
PVC	100 FT	9

TYPE OF COMPLETION: (Circle One or More): (Gravel Packed), Underreamed, Telescoped, Natural Development, Open Hole, Other (Describe)

WELL GROUTED TO A DEPTH OF _____ FEET
Type Grout (circle one): (Cement), Bentonite, or Mix

LOG DATA

TYPE OF LOG RUN (Circle One): No Log Run, Electric, Gamma Ray, Density, Sonic, Neutron, Other (Describe)

Name of Organization Running Log

GEOLOGIC DATA (Office Use Only)

Surface Elev.	Geologic Unit	Unit Thickness	Depth to Top
Subs. SWL	Date	Analysis	Aquifer Test

Driller's Remarks

Top of Lap Pipe or Reduction in Casing FEET

IF TELESCOPED OR MORE THAN ONE SCREEN: USE BACK PAGE

SCREEN DATA

Diameter - Inches	Length - Feet	Slot Size - Inches
4	30	0.10

Screen Type	Depth to Bottom - Feet
PVC	70-100

RECEIVED JUN 25 1996 Dept. of Environmental Quality Office of Land & Water Resources

DESCRIPTION OF FORMATIONS ENCOUNTERED	FROM	TO	FORMATIONS (Continued)	FROM	TO
Clay	0	5			
Sand	5	40			
Sand and Gravel	40	100			
			IF MORE SPACE IS NEEDED, USE BACK		

If well telescopes please
sketch and show depths.

GROUND LEVEL

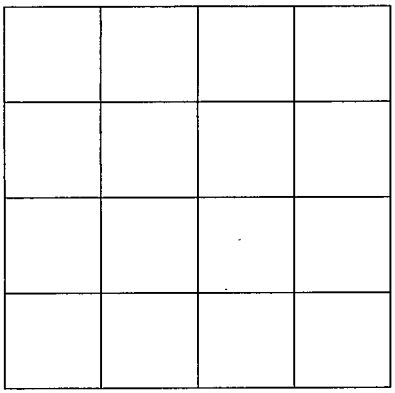

SECTION _____

Please indicate well location X.

ADDITIONAL INFORMATION

If more than one screen,
show location of each on sketch.