

MARION MISSISSIPPI BOARD OF WATER COMMISSIONERS

JQ8  
8-5-65

WATER WELL DRILLERS LOG

CODED

Date: 8-5 1966, Driller: Decord SS Rouse County Marion

~~H. H. FORBES~~

(Name)

(1) Owner of Land: H. H. FORBES

(Name)

Mrs Beanie Dee Forbes

(Address)

(2) Location: Early Hook 201-14

1/4, 1/4, Sec. T R

10 miles East of Whitland

(distance) (direction) (Nearest Town)

(3) Topography: \_\_\_\_\_

(Hilly) (Flat) (Level)

(4) Purpose of Well: Domestic

(Domestic Irrigation  
Municipal, Industrial, Other)

Description & Color of Materials Sand, Clay, Red Clay, Shell, etc.	Thick- ness Feet	Depth Feet
<u>Red clay</u>	<u>30</u>	
<u>Gravel and sand</u>	<u>1</u>	
<u>river sand</u>	<u>25</u>	
		<u>95</u>

CODED

Information upon completion of well:

(1) Diameter 4 inches.

(2) Total Depth 95 feet.

(3) Water Level 60 feet below top of ground.

(4) Cased to 89, Size 4

(5) Screen: Size 4, Length 6


(6) Were any formations sealed against pollution?

\_\_\_\_\_ yes,  no.

If YES depth of formation \_\_\_\_\_

Why \_\_\_\_\_

Drillers Remarks: \_\_\_\_\_

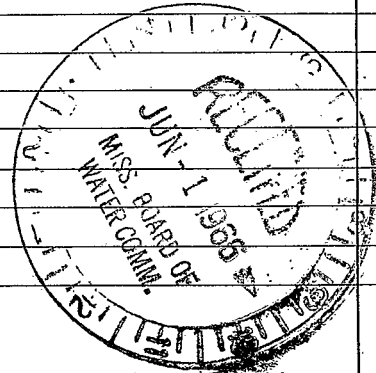

(Use Back Side)

Well No.




