MARSHALL
A33
1-19-72

MISSISSIPPI
BOARD OF WATER COMMISSIONERS
416 North State Street
Jackson, Mississippi 39201

CODED

WATER WELL DRILLERS LOG

Jan. 19 1972 R. L. Carpenter Marshall
date well completed — firm name — county well located

LANDOWNER: Jessie Hood
Collierville, Tenn.
RFD
(mailing address)

WELL LOCATION:
sec. 22 T 1 N (S) R 4 E (W)
2 1/4 miles North of Coyo
(distance) (direction) (nearest town)

WELL PURPOSE: Home
(home, irrigation, municipal, industrial)

WELL COMPLETION DATA:

(1) diameter (inches) 16
(2) total depth (feet) 148
(3) static water level (feet) 72 below above top of ground.
(4) casing Plastic, 142 ft.
(material) (depth)
_____ if telescope see back.
(size)
(5) screen 6 ft, 142 ft.
(length) (depth to top)
4 in, Plastic & Gravel
(size) (material)
(6) pump 3/4 10
(HP) (yield gpm)
Elec
(type power)
(7) electric log No.
(yes or no)
_____
(organization running log)
(8) how well bottom plugged Plastic Plug

DRILLERS REMARKS:

description of formations encountered	from	to
Surface Soil	0	12
Med Brown Sand	12	45
Med & fine white Sand	45	76
Coarse white Sand	76	90
white Clay	90	115
white Coarse Sand	115	148

CODED

AUG - 4 1972
MISS. BD. OF WATER COMM.

If well telescopes please sketch and show depths.

GROUND LEVEL

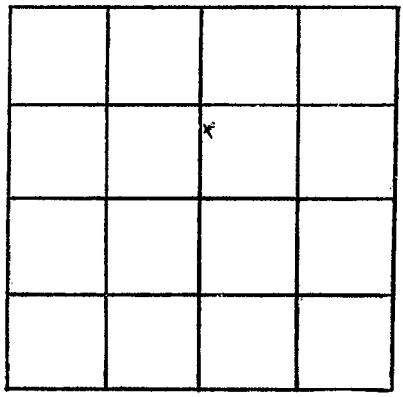

SECTION 22

Please indicate well location X.

ADDITIONAL INFORMATION

If more than one screen, show locations of each on sketch.