MARSHALL
B43
11-7-73

MISSISSIPPI
BOARD OF WATER COMMISSIONERS
416 North State Street
Jackson, Mississippi 39201 CODED

WATER WELL DRILLERS LOG

Nov. 7 1973 R. L. Carpenter Marshall
date well completed — firm name — county well located

LANDOWNER: Will Bob Hale
Mt. Pleasant, Miss.
RFD
(mailing address)

WELL LOCATION:
sec. 32 T 1 N (S) R 3 E (W)
2 miles (distance) West (direction) of Mt Pleasant (nearest town)

WELL PURPOSE: Home
(home, irrigation, municipal, industrial)

WELL COMPLETION DATA:

(1) diameter (inches) 4
(2) total depth (feet) 200
(3) static water level (feet) 139 below above top of ground.
(4) casing Plastic (material), 194 ft. (depth)
(size) if telescope see back.
(5) screen 6 ft. (length), 194 ft. (depth to top)
4 in. (size), Plastic & Gravel (material)
(6) pump 1/2 (HP) 8 (yield gpm)
Elec. (type power)
(7) electric log Yes (yes or no)
(organization running log)
(8) how well bottom plugged Plastic Cap

DRILLERS REMARKS:

description of formations encountered	from	to
Surface Soil	0	25
Med. Red Sand	25	48
Med. White Sand	48	76
White clay	76	90
White Fine Sand	90	160
White Coarse Sand	160	200

CODED

RECEIVED
MAR 12 1974
MISS. BD. OF WATER COMM.

If well telescopes please sketch and show depths.

GROUND LEVEL

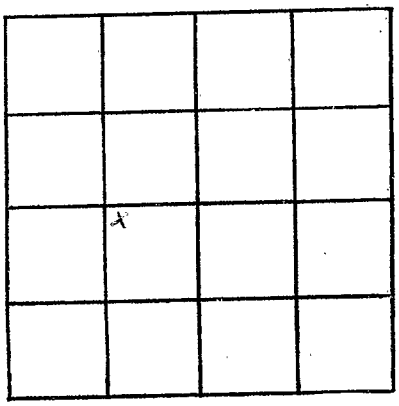

SECTION 32

Please indicate well location X.

ADDITIONAL INFORMATION

If more than one screen, show locations of each on sketch.