MARSHALL
B
12-16-77
2008

MISSISSIPPI
BOARD OF WATER COMMISSIONERS
416 North State Street
Jackson, Mississippi 39201

WATER WELL DRILLERS LOG

Dec 16 1977 — date well completed
R.L. Carpenter — firm name
Marshall — county well located

LANDOWNER: Lonnie Chandler
Mt. Pleasant
Miss.
(mailing address)

WELL LOCATION:
sec. 33 T 1 N/S R 3 E/W
1/2 miles (distance) west (direction) of Mt Pleasant (nearest town)

WELL PURPOSE: Home
(home, irrigation, municipal, industrial)

WELL COMPLETION DATA:

(1) diameter (inches) 4
(2) total depth (feet) 120
(3) static water level (feet) 90 below/above top of ground.
(4) casing Plastic (material), 118' (depth),
_____ (size) if telescope see back.
(5) screen 18' (length), 118' (depth to top)
4" (size), Plastic (material)
(6) pump 1/2 (HP) 8 (yield gpm)
Elec. (type power)
(7) electric log no. (yes or no)
_____ (organization running log)
(8) how well bottom plugged PVC Cap

DRILLERS REMARKS:

description of formations encountered	from	to
Surface Soil	0	15
Red & Brown Red Sand	15	40
White Clay	40	58
Red White Sand	58	70
White Clay	70	83
White Coarse Sand	83	120

Miss. Board of Water Comm.
MAR 12 1979
RECEIVED

If well telescopes please sketch and show depths.

GROUND LEVEL

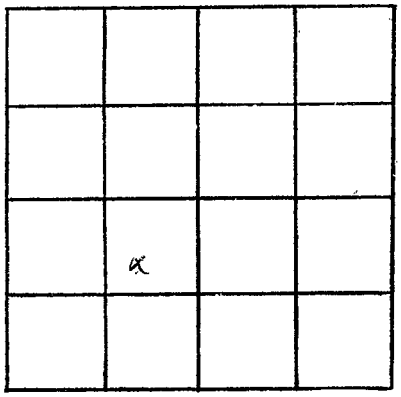

SECTION 33

Please indicate well location X.

ADDITIONAL INFORMATION

If more than one screen, show locations of each on sketch.