Marshall
B 2011

5/25/79

MISSISSIPPI
BOARD OF WATER COMMISSIONERS
416 North State Street
Jackson, Mississippi 39201

WATER WELL DRILLERS LOG

May 25 19 79 R. L. Campbell Marshall
date well completed — firm name — county well located

LANDOWNER: Glenn Riley
Mt. Pleasant, Miss.
~~R.F.D.~~
(mailing address)

WELL LOCATION:
sec. 33 T 1 N/S R 3 E/W
1/4 (distance) miles West (direction) of Mt. Pleasant (nearest town)

WELL PURPOSE: Home
(home, irrigation, municipal, industrial)

WELL COMPLETION DATA:
(1) diameter (inches) 4
(2) total depth (feet) 122
(3) static water level (feet) 80 below/above top of ground.
(4) casing Plastic (material), 112' (depth),
_____ (size) if telescope see back.
(5) screen 10' (length), 112' (depth to top)
4" (size), Plastic (material)
(6) pump 1/2 (HP) 10 (yield gpm)
Elec (type power)
(7) electric log no (yes or no)
_____ (organization running log)
(8) how well bottom plugged PVC Cap

DRILLERS REMARKS:

description of formations encountered	from	to
Surface Soil	0	10
Med Brown Sand	10	30
Med Brown & Red Sand	30	62
Med White Sand	62	96
White Clay	96	102
White Coarse Sand	102	122

DEPT. OF NATURAL RESOURCES
BUREAU OF LAND & WATER RESOURCES
MAY 18 1981
RECEIVED

If well telescopes please sketch and show depths.

GROUND LEVEL

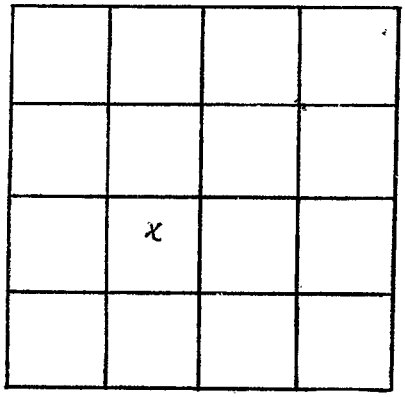

SECTION 33

Please indicate well location X.

ADDITIONAL INFORMATION

If more than one screen, show locations of each on sketch.