Marshall
B 2016

3/25/80

MISSISSIPPI
BOARD OF WATER COMMISSIONERS
416 North State Street
Jackson, Mississippi 39201

WATER WELL DRILLERS LOG

Mar. 25 1980 R. L. Carpenter Marshall
date well completed — firm name — county well located

LANDOWNER: Roger Woods
~~Mt. Pleasant~~ Holly Springs, Miss.
(mailing address)

WELL LOCATION:
sec. 32 T 1 N/S R 3 E/W
1 miles West of Mt Pleasant
(distance) (direction) (nearest town)

WELL PURPOSE: Subd.
(home, irrigation, municipal, industrial)

WELL COMPLETION DATA:

(1) diameter (inches) 4
(2) total depth (feet) 145
(3) static water level (feet) 80 below/above top of ground.
(4) casing PVC (material), 135' (depth),
_____ (size) if telescope see back.
(5) screen 10' (length), 135' (depth to top)
4" (size), PVC (material)
(6) pump 1 1/2 (HP) 20 (yield gpm)
Elec. (type power)
(7) electric log yes (yes or no)
_____ (organization running log)
(8) how well bottom plugged PVC Cap

DRILLERS REMARKS:

description of formations encountered	from	to
Surface Soil	0	14
Med Red Sand	14	40
White Clay	40	65
White Fine Sand	65	110
White Coarse Sand	110	145

DEPT. OF NATURAL RESOURCES
BUREAU OF LAND & WATER RESOURCES
MAY 18 1981
RECEIVED

If well telescopes please sketch and show depths.

GROUND LEVEL

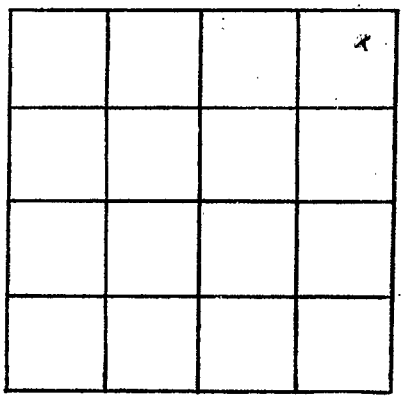

SECTION 32

Please indicate well location X.

ADDITIONAL INFORMATION

If more than one screen, show locations of each on sketch.