Marshall
C 2011

6/24/79

MISSISSIPPI
BOARD OF WATER COMMISSIONERS
416 North State Street
Jackson, Mississippi 39201

WATER WELL DRILLERS LOG

6-24 19 79 R. L. Carpenter Marshall
date well completed — firm name — county well located

LANDOWNER: Nelley Fuller
Lamar, Miss.
RFD
(mailing address)

WELL LOCATION:
sec. 35 T 1 N/S R 2 E/W
3 (distance) miles East (direction) of Slayden (nearest town)

WELL PURPOSE: Home
(home, irrigation, municipal, industrial)

WELL COMPLETION DATA:
(1) diameter (inches) 4
(2) total depth (feet) 185
(3) static water level (feet) 92 below/above top of ground.
(4) casing Plastic (material), 175' (depth),
_____ (size) if telescope see back.
(5) screen 18' (length), 175' (depth to top)
4" (size), Plastic (material)
(6) pump 1/2 (HP) 9 (yield gpm)
Elec (type power)
(7) electric log No. (yes or no)
_____ (organization running log)
(8) how well bottom plugged PVC cap

DRILLERS REMARKS:

description of formations encountered	from	to
Surface Soil	0	20
Med & Coarse Red Sand	20	38
Med. white Sand	38	76
White Clay & Fine Sand	76	90
White Med. Sand	90	130
White Coarse Sand	130	185

DEPT. OF NATURAL RESOURCES
BUREAU OF LAND & WATER RESOURCES
MAY 18 1981
RECEIVED

If well telescopes please sketch and show depths.

GROUND LEVEL

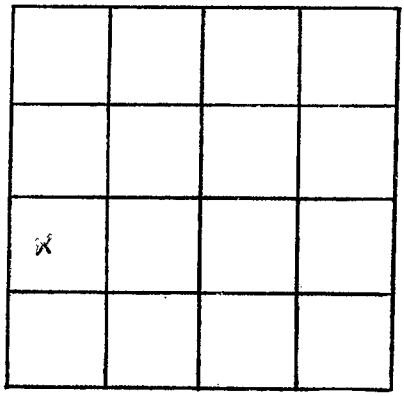

SECTION 35

Please indicate well location X.

ADDITIONAL INFORMATION

If more than one screen, show locations of each on sketch.