MARSHALL
D 2016

6/3/80

MISSISSIPPI
BOARD OF WATER COMMISSIONERS
416 North State Street
Jackson, Mississippi 39201

WATER WELL DRILLERS LOG

June 3 (date well completed) 19 80 — R.L. Carpenter (firm name) — Marshall (county well located)

LANDOWNER: Pine Ingram
Byhalia, Miss
RFD
(mailing address)

WELL LOCATION:
sec. 2 T 2 N (S) R 5 E (W)
2 (distance) miles South (direction) of Barton (nearest town)

WELL PURPOSE: Stock
(home, irrigation, municipal, industrial)

WELL COMPLETION DATA:

(1) diameter (inches) 4
(2) total depth (feet) 75
(3) static water level (feet) 15 below above top of ground.
(4) casing PVC (material), 65' (depth),
_____ (size) if telescope see back.
(5) screen 10' (length), 65' (depth to top)
4" (size), PVC (material)
(6) pump 3/4 (HP) 12 (yield gpm)
Elec (type power)
(7) electric log No (yes or no)
_____ (organization running log)
(8) how well bottom plugged PVC Cap

DRILLERS REMARKS:

description of formations encountered	from	to
Surface Soil	0	12
White & Red Coarse Sand	12	30
White Clay	30	40
White Coarse Sand	40	75

DEPT. OF NATURAL RESOURCES
BUREAU OF LAND & WATER RESOURCES
MAY 18 1981
RECEIVED

If well telescopes please sketch and show depths.

GROUND LEVEL

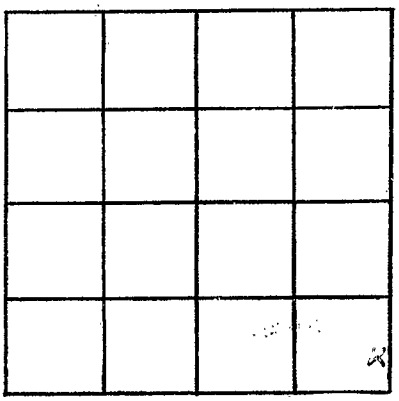

SECTION 2

Please indicate well location X.

ADDITIONAL INFORMATION

If more than one screen, show locations of each on sketch.