MARSHALL
E53
6-20-72

MISSISSIPPI
BOARD OF WATER COMMISSIONERS
416 North State Street
Jackson, Mississippi 39201

CODED

WATER WELL DRILLERS LOG

June 20 1972 R. L. Carpenter Marshall
date well completed — firm name — county well located

LANDOWNER: W. P. Lightsey
Red Banks, Miss
RFD
(mailing address)

WELL LOCATION:
sec. 12 T. 2 N (S) R. 4 E (W)
6 miles North of Red Banks
(distance) (direction) (nearest town)

WELL PURPOSE: Dairy
(home, irrigation, municipal, industrial)

WELL COMPLETION DATA:
(1) diameter (inches) 6 in
(2) total depth (feet) 240
(3) static water level (feet) 185 below above top of ground.
(4) casing Plastic (material), 200 ft. (depth)
_____ (size) if telescope see back.
(5) screen 40 ft. (length), 200 ft. (depth to top)
6 in. (size), Plastic & Gravel (material)
(6) pump 15 (HP) 290 (yield gpm)
Elec. (type power)
(7) electric log No (yes or no)
_____ (organization running log)
(8) how well bottom plugged Plastic Cap

DRILLERS REMARKS:

description of formations encountered	from	to
Surface Soil	0	12
Med. Red Sand	12	28
White Clay	28	36
White Fine Sand & White Clay	36	49
White Fine Sand	49	62
White Coarse Sand	62	90
Med White Sand	90	150
White Clay	150	160
Blue Marl	160	170
White Clay & White Fine Sand	170	185
White Coarse Sand	185	240

CODED

AUG - 4 1972
MISS. WATER COMM.

If well telescopes please sketch and show depths.

GROUND LEVEL

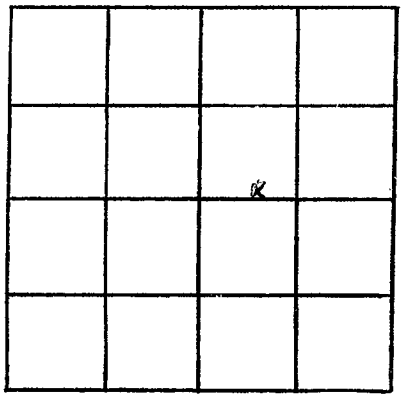

SECTION 12

Please indicate well location X.

ADDITIONAL INFORMATION

If more than one screen, show locations of each on sketch.