Marshall
E 87
3-22-75

MISSISSIPPI
BOARD OF WATER COMMISSIONERS
416 North State Street
Jackson, Mississippi 39201

WATER WELL DRILLERS LOG

CODED

3-22-1975 — date well completed
W. Q. Mason Water Well Contractor — firm name
Marshall — county well located

LANDOWNER: Willie J. Perkins
RFD, Byhalia Miss.
(mailing address)

WELL LOCATION: sec. 18 T 2 N (S) R 4 (E) (W) 15E
3 miles (distance) NE (direction) of Byhalia (nearest town)

WELL PURPOSE: Home
(home, irrigation, municipal, industrial)

WELL COMPLETION DATA:

(1) diameter (inches) 4"
(2) total depth (feet) 162'
(3) static water level (feet) 90' below ~~above~~ top of ground.
(4) casing Plastic (material), 152' (depth), 4" (size) if telescope see back.
(5) screen 10' (length), 152' (depth to top), 4" (size), Plastic (material)
(6) pump 1/2 (HP) 10 (yield gpm) electric (type power)
(7) electric log No (yes or no)
(organization running log)
(8) how well bottom plugged Cap on Screen

DRILLERS REMARKS:

description of formations encountered	from	to
Clay Loam	40	16
red Clay	16	20
red Sand	20	60
white Sand	60	104
white Clay	104	107
" " Sand	107	162

RECEIVED
JUL 01 1975
BOARD OF WATER COMM.

If well telescopes please sketch and show depths.

GROUND LEVEL

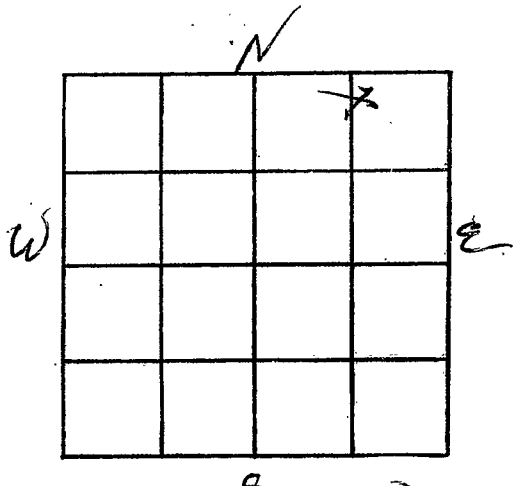

SECTION 18

Please indicate well location X.

ADDITIONAL INFORMATION

If more than one screen, show locations of each on sketch.