Marshall
E 89
5-21-75

MISSISSIPPI
BOARD OF WATER COMMISSIONERS
416 North State Street
Jackson, Mississippi 39201

CODED

WATER WELL DRILLERS LOG

May 21 1975 R. L. Carpenter Marshall
date well completed — firm name — county well located

LANDOWNER: Tom Smith
Coyce, Miss
RFD
(mailing address)

WELL LOCATION:
sec. 16 T 2 N (S) R 4 E (W) 15E
3 miles South of Coyce
(distance) (direction) (nearest town)

WELL PURPOSE: Home
(home, irrigation, municipal, industrial)

WELL COMPLETION DATA:

(1) diameter (inches) 4
(2) total depth (feet) 127
(3) static water level (feet) 60 below above top of ground.
(4) casing Plastic, 121'
(material), (depth)
_____ (size) if telescope see back.
(5) screen 6', 121'
(length), (depth to top)
4", Plastic Gravel
(size), (material)
(6) pump 1/2 9
(HP) (yield gpm)
Elec
(type power)
(7) electric log No
(yes or no)
_____
(organization running log)
(8) how well bottom plugged Plastic cap

DRILLERS REMARKS:

description of formations encountered	from	to
Surface Soil	0	15
Fine Red Sand	15	36
White Clay & White Fine Sand	36	73
Red. White Sand	73	98
White Coarse Sand	98	127

CODED

RECEIVED
MAY 22 1975
MISS. BD. OF WATER COMM.

If well telescopes please sketch and show depths.

GROUND LEVEL

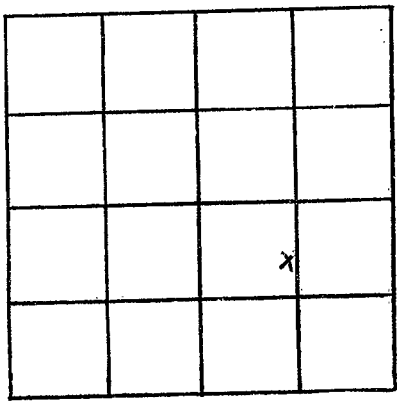

SECTION 16

Please indicate well location X.

ADDITIONAL INFORMATION

If more than one screen, show locations of each on sketch.