County: Marshall

Permit #: 0162

Driller: Larry Carpenter

Date drilling completed: 4-24-09

State Well Report

Part 1 – Driller's Log

Mississippi Department of Environmental Quality
Office of Land and Water Resources
P.O. Box 10631
Jackson, MS 39289-0631
(601)961-5210
(601)354-6938 (fax)

For Office Use Only:

Aquifer:

Well #: E-235

L. S. Elevation:

E-log #:

State Law requires that this report be prepared by the license holder responsible for the work and filed with the Department at the above address within 30 days of completion of drilling of the well or borehole.

Information on Well Owner
(Landowner if borehole is not for a water well)

Owner Name: Mitchell Ramon

Mailing Address: 1528 Coyle Rd.

Byhalia (City) Ms. (State) 38611 (Zip Code)

Telephone No. (901) 239-6696

Well or Borehole Location

Latitude: 34 : 53 : 17 Longitude: 89° 37 03"

Method of Lat/Long (circle one): Conventional Survey,

USGS quad, Hand-held GPS, Survey-grade GPS

NW¼ NW¼ Sec 27 Twn 2S Rng 4W

Distance 3 Miles Direction North of Nearest Town Victoria

Well / Borehole Data

Date drilling started: 4-24-09 Date drilling completed: 4-24-09 Hole depth: 125' Hole diameter: 8"

Location of the source of any surface water used for drilling: Well Water
Method of dosing and volume of Chlorine used in drilling and development: ½ Pt. Chlorine to 1000 Gal Water

Logs run (circle all applicable): (No log run) Electric Gamma Ray Density Sonic Neutron Other:
Name of organization running log(s):

Purpose of borehole (check one): Water Well X Geotechnical/Geological Investigation___ Ground Source Heat Pump___

Seismic Survey___ Other (***describe***)

If drilling is not related to water well construction, skip the remainder of this block

Purpose of Well (check one): Home X Industrial___ Public Supply___ Irrigation___ Fish Culture ___ Other:

If a flowing well, method of flow regulation: Valve _____ Other (describe)

Static Water Level: 86 feet above or (below) (circle one) land surface Date measured: 4-24-09

Method of Measurement (circle one) (steel tape) electric tape air line other:

Well depth: 125' Well grouted to a depth of 10 feet Type of grout (circle one) (Neat Cement) Bentonite Mix

Casing length: 115 feet Casing diameter: 4 inches Type of casing: PVC

Screen length: 10 feet Screen diameter: 4 inches Type of screen: PVC

Screen slot size: .013 inches Setting depth: From 115 feet to 125 feet

Type of completion (circle all applicable): (Gravel packed) Underreamed Telescoped Open hole Natural Development

Other (describe):

Top of lap pipe or reduction in casing: _____ feet. ***If telescoped or more than one screen, describe on next page***

RECEIVED
Form: OLWR-SWR-1A
MAY 21 2009
BY: OLWR

E-235

The sketch below only required for water wells

If well telescopes, show depths on sketch.

Ground Level

If more than one screen, show location of each on sketch

Description of formations encountered must be provided for all wells and boreholes, unless specifically exempted by regulations

Description of Formations Encountered	From (depth) Ground Level	To (depth)
Surface Soil	0	20
Med Red Sand	20	43
Med White Sand	43	70
White Clay	70	82
Med. White Sand	82	100
Coarse White Sand	100	125

Sketch the property layout and include the following: 1) the well location; 2) any permanent structures on the property that may aid in locating the well; 3) any roads, power lines, or other items that may aid in locating the property and the well; 4) a north arrow.

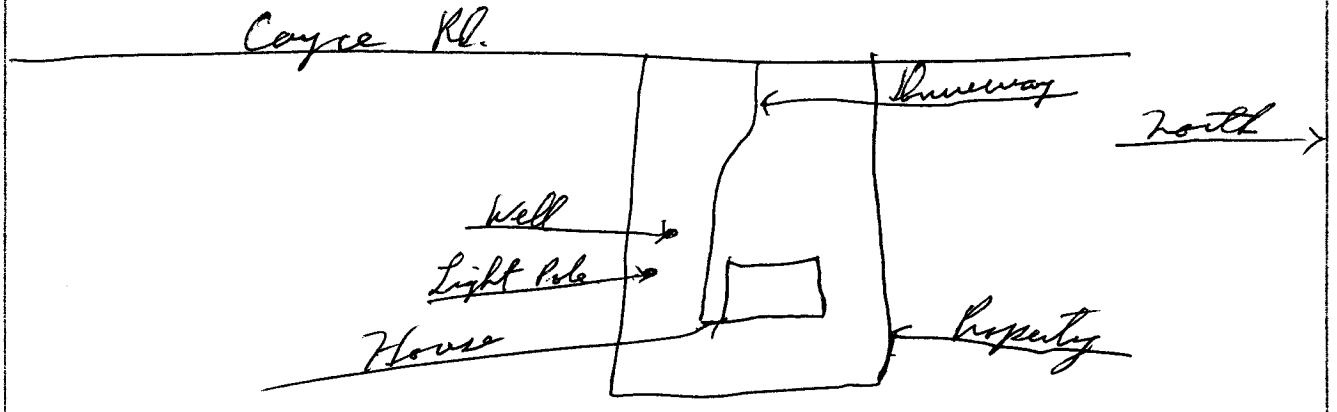

Landowner Name: Mitchell Norman

Form: OLWR-SWR-1A

I certify that the well/borehole was drilled, constructed, and completed in accordance with all applicable requirements of the Mississippi Department of Environmental Quality and the Mississippi Department of Health regulations, if applicable, and state laws.

LARRY CARPENTER 0-162 | 5-10-09 | Larry Carpenter

Print Name of Responsible Licensee and License No. | **Date** | **Signature of Licensee**

RECEIVED
MAY 21 2009
BY: OLWR

STATE WELL REPORT

Part 2

Pump Installer's Completion Report
Mississippi Department of Environmental Quality
Office of Land and Water Resources
P.O. Box 10631
Jackson, MS 39289-0631
(601)961-5210
(601)354-6938 (fax)

County: Marshall
Permit #: O-162
Driller: Larry Carpenter
Date completed: 4-24-09
Copy information from block on Part 1

For Office Use Only:
Aquifer:
Well #: E-235
Elevation:

This part of the report must be completed by a licensed water well contractor or a licensed pump installer. A copy of Part 1 of the report must be attached and both parts filed with the Department at the above address within 30 days of well completion.

Well Owner Information

Owner Name: Mitchell Norman
Mailing Address: 1528 Coyne Rd
Byhalia (City) Ms. (State) 38611 (Zip Code)
Telephone No. (901) 239-6696

Well Location

Latitude: _____ Longitude: _____
Method of Lat/Long (check one): Conventional Survey___, USGS quad___, Hand-held GPS___, Survey-grade GPS___
___¼ ___¼ Sec 27 T 2S R 4W
Distance: 3 Miles Direction: North of Nearest Town: Victoria

Pump Type
Circle one

Air Lift | Jet | (Submersible) | Bucket | Piston | Turbine | Centrifugal | Rotary | Flowing Well
Other (specify): _____
Date Pump Installed: 4-24-09
Rated Pump Capacity: 10 Gallons Per Minute

Power Type
Circle one

Diesel Engine | Gasoline Engine | Natural Gas | (Electric Motor) | Hand | Tractor PTO | Windmill | Other (specify): _____
Horse Power Rating of Motor: 3/4
Setting Depth: 180 feet
Number of Stages: 11

Pump Test Data

Date Well Tested: 4-24-09
Static Water Level (A): 80 Feet Below Land Surface
Pumping Water Level (B): 85 Feet Below Land Surface
Drawdown [(B) – (A)]: 5 Feet Below Land Surface
Test Pumping Rate: 17 Gallons Per Minute
Duration of Pump Test (minimum 4 hours): 4 hours

Method of Measuring Water Level
Circle one

Air Line | Electric Measuring Line | (Steel Tape)
Other (specify): _____
For flowing well, measured shut in head: _____ feet
Well yielded 17 GPM with a drawdown of 5 feet after 4 hours of pumping

I HEREBY CERTIFY that the above statements are true to the best of my knowledge.

LARRY CARPENTER O-162
Print Name of Pump Installer and License No. (if applicable)

Larry Carpenter
Signature of Pump Installer

Form: OLWR-SWR-1B

RECEIVED
MAY 21 2009
BY: OLWR