Marshall
E 2038

11/16/80

MISSISSIPPI
BOARD OF WATER COMMISSIONERS
416 North State Street
Jackson, Mississippi 39201

WATER WELL DRILLERS LOG

Nov. 16 1980 — date well completed
R.L. Carpenter — firm name
Marshall — county well located

LANDOWNER: J. D. Shipp
Victoria, Miss
RFD
(mailing address)

WELL LOCATION:
sec. 26 T 2 N/S R 4 E/W
3 miles (distance) North (direction) of Victoria (nearest town)

WELL PURPOSE: Home
(home, irrigation, municipal, industrial)

WELL COMPLETION DATA:
(1) diameter (inches) 4
(2) total depth (feet) 130
(3) static water level (feet) 20 below/above top of ground.
(4) casing PVC (material), 120' (depth),
(size) if telescope see back.
(5) screen 10' (length), 120' (depth to top)
4" (size), PVC (material)
(6) pump 1/2 (HP) 10 (yield gpm)
Elec (type power)
(7) electric log No (yes or no)
(organization running log)
(8) how well bottom plugged PVC cap

DRILLERS REMARKS:

description of formations encountered	from	to
Surface Soil	0	14
Med & coarse Red Sand	14	35
white Med Sand	35	46
white Clay	46	80
white fine Sand	80	98
white coarse Sand	98	130

DEPT. OF NATURAL RESOURCES
BUREAU OF LAND & WATER RESOURCES
MAY 18 1981
RECEIVED

If well telescopes please sketch and show depths.

GROUND LEVEL

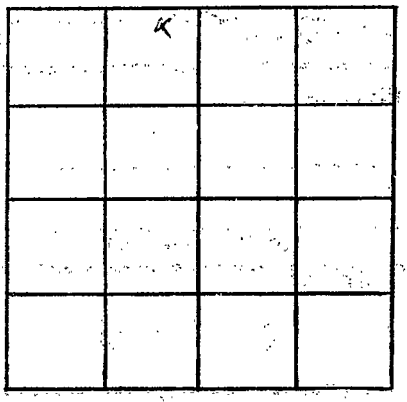

SECTION 26

Please indicate well location X.

ADDITIONAL INFORMATION

If more than one screen show locations of each on sketch.

DEPT. OF NATURAL RESOURCES
BUREAU OF LAND AND WATER RESOURCES