MISSISSIPPI DEPARTMENT OF NATURAL RESOURCES

Bureau of Land and Water Resources

P.O. Box 10631
Jackson, Mississippi 39209

WATER WELL DRILLERS LOG

COUNTY WELL LOCATED: Marshall	PERMIT NUMBER:
WELL NUMBER: E 209 — CODED:	NAME OF DRILLING FIRM: Hicks Well Co
DATE WELL COMPLETED: 8-21-86	RT-1 Senatobia

NAME & MAILING ADDRESS OF LANDOWNER
Edward Yancey
RT. 1 Box 410cc
Byhalia MS- 38611

WELL LOCATION: SEC 24 TOWNSHIP 2 N/S RANGE 4 E/W

DISTANCE 3 Miles DIRECTION E of NEAREST TOWN Victoria

OTHER LANDMARK

WELL PURPOSE: Home, Irrigation, Municipal, Industrial, Fish Pond, etc.

PUMP DATA

PUMP TYPE (Circle One): Submersible, Turbine, Jet, Flowing Well, Other (Describe)

POWER TYPE (Circle One): Electric, Tractor, Diesel, Gasoline, Butane, Other (Describe)

Pump Capacity (GPM)	No. of Stages	Setting Depth
10	10	100 FT.

PUMP TEST

Well yielded 10 GPM with a drawdown of 0 ft. after _____ hours of pumping

WELL DATA

Well Depth	Casing Diameter (In.)	Casing Length (Ft.)
140	4"	130

Type of Casing	Hole Depth	Depth to Static Water Level
PVC	140	80

TYPE OF COMPLETION: (Circle One or More): Gravel Packed, Underreamed, Telescoped, Natural Development, Open Hole, Other (Describe)

Top of Lap Pipe or Reduction in Casing FEET

IF TELESCOPED OR MORE THAN ONE SCREEN: USE BACK PAGE

SCREEN DATA

Diameter - Inches	Length - Feet	Slot Size - Inches
4"	10	013

Screen Type	Depth to Bottom - Feet
PVC slotted	10

LOG DATA

TYPE OF LOG RUN (Circle One): No Log Run, Electric, Gamma Ray, Density, Sonic, Neutron, Other (Describe)

Name of Organization Running Log

GEOLOGIC DATA (Office Use Only)

Surface Elev.	Geologic Unit	Unit Thickness	Depth to Top
Subs. SWL	Date	Analysis	Aquifer Test

Driller's Remarks

RECEIVED
SEP 04 1986
Department of Natural Resources
Bureau of Land & Water Resources

DESCRIPTION OF FORMATIONS ENCOUNTERED	FROM	TO
Red CLAY	0	10
Red - Sand & C	10	90
W CLAY & SAND	90	120
W - S.	120	140

FORMATIONS (Continued)	FROM	TO

IF MORE SPACE IS NEEDED, USE BACK

If well telescopes please
sketch and show depths.

GROUND LEVEL

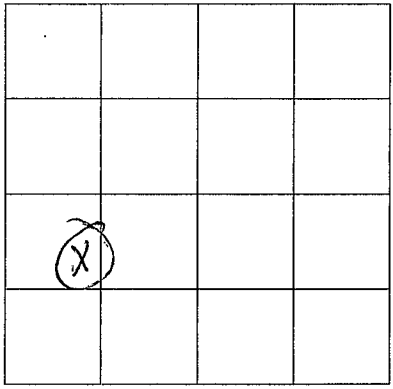

SECTION _____

Please indicate well location X.

ADDITIONAL INFORMATION

If more than one screen,
show location of each on sketch.