MISSISSIPPI DEPARTMENT OF NATURAL RESOURCES

Bureau of Land and Water Resources

P.O. Box 10631
Jackson, Mississippi 39209
WATER WELL DRILLERS LOG

COUNTY WELL LOCATED: Marshall

WELL NUMBER: E 2084 CODED

DATE WELL COMPLETED: 6-22-87

PERMIT NUMBER:

NAME OF DRILLING FIRM: HICKS WELL COMPANY
RT. 1 · BOX 157
SENATOBIA, MISS.

NAME & MAILING ADDRESS OF LANDOWNER:
Noonan Young
P.O. Box 233
Victoria, MS 38679

WELL LOCATION: SEC 28 TOWNSHIP 2 N/S RANGE 4 E/W

DISTANCE 2 Miles DIRECTION N of NEAREST TOWN Victoria

OTHER LANDMARK:

WELL PURPOSE: Home, Irrigation, Municipal, Industrial, Fish Pond, etc.

PUMP DATA

PUMP TYPE (Circle One): Submersible, Turbine, Jet, Flowing Well, Other (Describe)

POWER TYPE (Circle One): Electric, Tractor, Diesel, Gasoline, Butane, Other (Describe)

Pump Capacity (GPM)	No. of Stages	Setting Depth
10	7	120 FT.

PUMP TEST

Well yielded _____ GPM with a drawdown of _____ ft. after _____ hours of pumping

WELL DATA

Well Depth	Casing Diameter (In.)	Casing Length (Ft.)
160'	4"	150'

Type of Casing	Hole Depth	Depth to Static Water Level
PVC	160'	100'

TYPE OF COMPLETION: (Circle One or More): Gravel Packed, Underreamed, Telescoped, Natural Development, Open Hole, Other (Describe) PVC Cap

Top of Lap Pipe or Reduction in Casing: FEET

IF TELESCOPED OR MORE THAN ONE SCREEN: USE BACK PAGE

LOG DATA

TYPE OF LOG RUN (Circle One): No Log Run, Electric, Gamma Ray, Density, Sonic, Neutron, Other (Describe)

Name of Organization Running Log

GEOLOGIC DATA (Office Use Only)

Surface Elev.	Geologic Unit	Unit Thickness	Depth to Top
Subs. SWL	Date	Analysis	Aquifer Test

Driller's Remarks

SCREEN DATA

Diameter - Inches	Length - Feet	Slot Size - Inches
4"	10'	.013

Screen Type	Depth to Bottom - Feet
PVC	160'

DESCRIPTION OF FORMATIONS ENCOUNTERED	FROM	TO
Red clay	0	15
Red sand	15	30
White sand	30	160

FORMATIONS (Continued) FROM TO

RECEIVED
SEP 16 1987
Department of Natural Resources
Bureau of Land & Water Resources

IF MORE SPACE IS NEEDED, USE BACK

If well telescopes please
sketch and show depths.

GROUND LEVEL

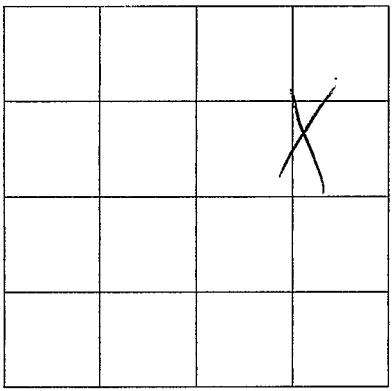

SECTION 28

Please indicate well location X.

ADDITIONAL INFORMATION

If more than one screen,
show location of each on sketch.