MARSHALL
G 2021

3/23/79

MISSISSIPPI
BOARD OF WATER COMMISSIONERS
416 North State Street
Jackson, Mississippi 39201

WATER WELL DRILLERS LOG

Mar 23 1979 — date well completed
R. L. Carpenter — firm name
Marshall — county well located

LANDOWNER: Eddie B. Jones
Lamar, Miss.
R F D
(mailing address)

WELL LOCATION:
sec. 7 T 2 N/S R 2 E/W
2 (distance) miles South (direction) of Slayden (nearest town)

WELL PURPOSE: Home
(home, irrigation, municipal, industrial)

WELL COMPLETION DATA:
(1) diameter (inches) 4
(2) total depth (feet) 165
(3) static water level (feet) 96 below/above top of ground.
(4) casing Plastic (material), 155' (depth)
_____ (size) if telescope see back.
(5) screen 18' (length), 155' (depth to top)
4" (size), Plastic (material)
(6) pump 1/2 (HP) 9 (yield gpm)
Elec (type power)
(7) electric log No (yes or no)
_____ (organization running log)
(8) how well bottom plugged PVC Cap

DRILLERS REMARKS:

description of formations encountered	from	to
Surface Soil	0	18
Red Red Sand	18	38
Red White Sand	38	75
White Clay	75	110
Red White & fine Sand mixed	110	120
White Coarse Sand	120	165

DEPT. OF NATURAL RESOURCES
BUREAU OF LAND & WATER RESOURCES
MAY 19 1981
RECEIVED

If well telescopes please sketch and show depths.

GROUND LEVEL

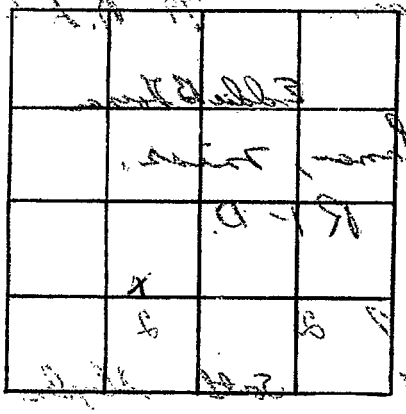

SECTION 2

Please indicate well location X.

ADDITIONAL INFORMATION

If more than one screen, show locations of each on sketch.