Marshall
G 2034

1/10/80

MISSISSIPPI
BOARD OF WATER COMMISSIONERS
416 North State Street
Jackson, Mississippi 39201

WATER WELL DRILLERS LOG

Jan 10 1980 R. L. Carpenter Marshall
date well completed — firm name — county well located

LANDOWNER: James Bryson
Lonar, Miss
RFD
(mailing address)

WELL LOCATION:
sec 22 T 2 N/S R 2 E/W
4 (distance) miles 5W (direction) of Slayden (nearest town)

WELL PURPOSE: Home
(home, irrigation, municipal, industrial)

WELL COMPLETION DATA:

(1) diameter (inches) 4
(2) total depth (feet) 185
(3) static water level (feet) 20 below above top of ground.
(4) casing PVC (material), 175' (depth)
_____ (size) if telescope see back.
(5) screen 10' (length), 175' (depth to top)
4" (size), PVC (material)
(6) pump 1/2 (HP) 10 (yield gpm)
Elec (type power)
(7) electric log no (yes or no)
_____ (organization running log)
(8) how well bottom plugged PVC Cap

DRILLERS REMARKS:

description of formations encountered	from	to
Surface Soil	0	15
Red. Red Sand	15	35
Red. White Sand	35	90
White Clay	90	120
White Fine Sand	120	145
White Coarse	145	185

DEPT. OF NATURAL RESOURCES
BUREAU OF LAND & WATER RESOURCES
MAY 18 1981
RECEIVED

If well telescopes please sketch and show depths.

GROUND LEVEL

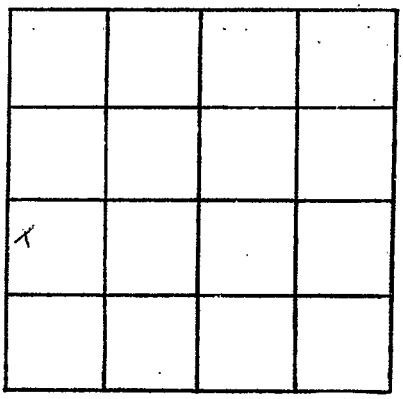

SECTION 22

Please indicate well location X.

ADDITIONAL INFORMATION

If more than one screen, show locations of each on sketch.