MARSHALL
H 53
9-26-72

MISSISSIPPI
BOARD OF WATER COMMISSIONERS
416 North State Street
Jackson, Mississippi 39201

WATER WELL DRILLERS LOG

Sept. 26 19 72 R. L. Carpenter Marshall
date well completed — firm name — county well located

LANDOWNER: J. C. Monaghan
Byhalia, Miss.
(mailing address)

WELL LOCATION:
sec. 3 T 3 N (S) R 5 E (W)
2 (distance) miles Southeast (direction) of Byhalia (nearest town)

WELL PURPOSE: Home
(home, irrigation, municipal, industrial)

WELL COMPLETION DATA:
(1) diameter (inches) 4 in
(2) total depth (feet) 126 ft.
(3) static water level (feet) 55 below above top of ground.
(4) casing Plastic (material), 125 ft (depth)
(size) if telescope see back.
(5) screen 6 ft. (length), 125 ft (depth to top)
4 in. (size), Plastic Gravel (material)
(6) pump 1/2 (HP) 8 (yield gpm)
Elec. (type power)
(7) electric log No (yes or no)
(organization running log)
(8) how well bottom plugged Plastic Plug

DRILLERS REMARKS:

description of formations encountered	from	to
Surface Soil	0	15
Med. Brown Sand	15	41
Med white Sand	41	68
White Clay	68	68
White Coarse Sand	68	126

COPY
COPIED
FEB 19 1973

If well telescopes please sketch and show depths.

GROUND LEVEL

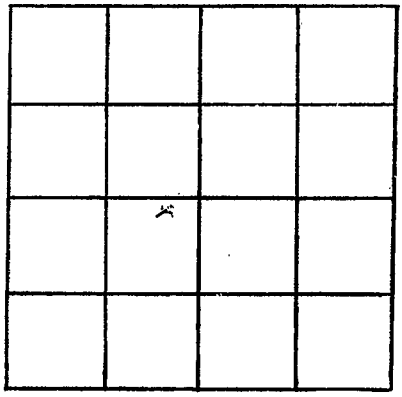

SECTION 3

Please indicate well location X.

ADDITIONAL INFORMATION

If more than one screen, show locations of each on sketch.