

MISSISSIPPI DEPARTMENT OF NATURAL RESOURCES

Bureau of Land and Water Resources

Southport Mall

P.O. Box 10631

Jackson, Mississippi 39209

WATER WELL DRILLERS LOG

MARSHALL  
H 2046

6-21- 1986 Sulphur Water Well Marshall  
date well completed firm name county well located


LANDOWNER: Archie M. David  
Rt. 3 Box 26A  
Byhalia, Mo. 38611  
(mailing address)

description of formations encountered	from	to
<u>Clay</u>	<u>0'</u>	<u>15'</u>
<u>Red sand &amp; gravel</u>	<u>15'</u>	<u>40'</u>
<u>White sand &amp; clay</u>	<u>40'</u>	<u>80'</u>
<u>White sand</u>	<u>80'</u>	<u>120'</u>

WELL LOCATION:  
sec. 3 T. 3 N. R. 5 E  
20 miles SW of Byhalia  
(distance) (direction) (nearest town)

WELL PURPOSE: Home  
(home, irrigation, municipal, industrial)

- WELL COMPLETION DATA:
- (1) diameter (inches) 4"
  - (2) total depth (feet) 120'
  - (3) static water level (feet) 75' <sup>below</sup> above top of ground.
  - (4) casing PVC, 110',  
(material) (depth)  
4" if telescope see back.  
(size)
  - (5) screen 10', 110',  
(length) (depth to top)  
4", PVC  
(size) (material)
  - (6) pump 3/4, 10  
(HP) (yield gpm)  
Elec  
(type power)
  - (7) electric log No  
(yes or no)
  - (organization running log)
  - (8) how well bottom plugged Cap

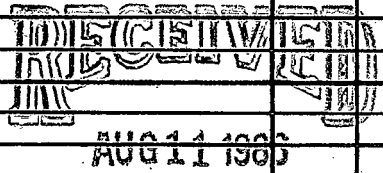


Department of Natural Resources  
Bureau of Land & Water Resources

DRILLERS REMARKS:

If well telescopes please sketch and show depths.

GROUND LEVEL

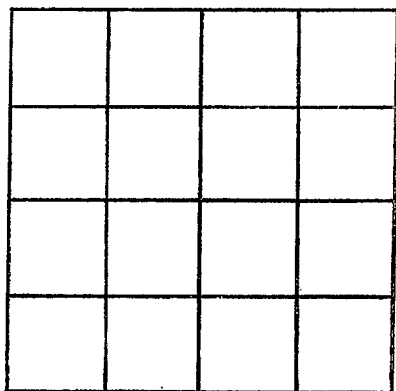

SECTION \_\_\_\_\_

Please indicate well location X.

ADDITIONAL INFORMATION

If more than one screen, show locations of each on sketch.