MARSHALL
J 71
2-10-72

MISSISSIPPI
BOARD OF WATER COMMISSIONERS
416 North State Street
Jackson, Mississippi 39201

WATER WELL DRILLERS LOG

CODED

2-10- 1972 — date well completed
Bob Smith — firm name
Marshall — county well located

LANDOWNER: Willie Sweet
Coxey, Miss. (mailing address)

WELL LOCATION:
sec. 33 T 1 N (S) R 4 E (W)
0 (distance) miles 0 (direction) of Coxey (nearest town)

WELL PURPOSE: Home (home, irrigation, municipal, industrial)

WELL COMPLETION DATA:

(1) diameter (inches) 4
(2) total depth (feet) 120
(3) static water level (feet) 45 below above top of ground.
(4) casing Plastic (material), 120 (depth),
_____ (size) if telescope see back.
(5) screen 20 (length), 100 (depth to top)
4 (size), Plastic (material)
(6) pump 1/3 (HP) 10 (yield gpm)
Elec (type power)
(7) electric log no (yes or no)
_____ (organization running log)
(8) how well bottom plugged plugged

DRILLERS REMARKS:

description of formations encountered	from	to
top soil	0	5
red clay	5	40
sand	40	120

CODED

MAR 27 1972

MISS. BD. OF WATER COMM.

If well telescopes please sketch and show depths.

GROUND LEVEL

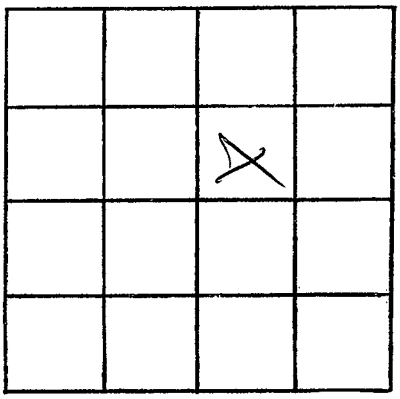

SECTION _____

Please indicate well location X.

ADDITIONAL INFORMATION

If more than one screen, show locations of each on sketch.