Marshall
J 2067
7-29-81

MISSISSIPPI
BOARD OF WATER COMMISSIONERS
416 North State Street
Jackson, Mississippi 39201

WATER WELL DRILLERS LOG

July 29 1981 Earl Jones Well Co Marshall
date well completed firm name county well located

LANDOWNER: Katie McGuire
Victoria Miss. 38679
(mailing address)

WELL LOCATION:
sec. 9 T 3 N R 4 E
1/10 miles S of Victoria
(distance) (direction) (nearest town)

WELL PURPOSE: Home
(home, irrigation, municipal, industrial)

WELL COMPLETION DATA:

(1) diameter (inches) 4"
(2) total depth (feet) 125'
(3) static water level (feet) 52 below ~~above~~ top of ground.
(4) casing Plastic (material), 115 (depth), 4" (size) if telescope see back.
(5) screen 10' (length), 115 (depth to top) .013-4" (size), Plastic (material)
(6) pump 1/2 (HP) 15 (yield gpm) electric (type power)
(7) electric log no (yes or no)
(organization running log)
(8) how well bottom plugged Plastic Cap

DRILLERS REMARKS:

description of formations encountered	from	to
Topsoil	0	2
Sand	2	27
Clay	27	32
Sand	32	50
Clay	50	52
Sand	52	125

AUG 1981 RECEIVED

If well telescopes please sketch and show depths.

GROUND LEVEL

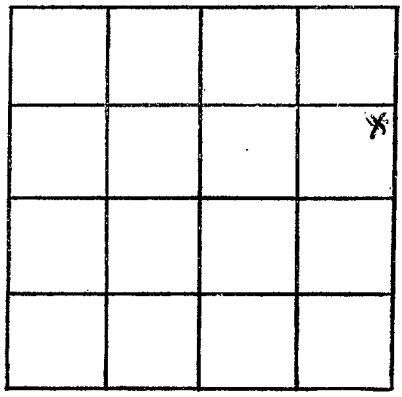

SECTION 9

Please indicate well location X.

ADDITIONAL INFORMATION

If more than one screen, show locations of each on sketch.