Marshall
K 2017
7-26-78

# MISSISSIPPI
## BOARD OF WATER COMMISSIONERS
416 North State Street
Jackson, Mississippi 39201

## WATER WELL DRILLERS LOG

July 26 1978 R. L. Carpenter Marshall
date well completed — firm name — county well located

LANDOWNER: Carnock Lommen
Holly Springs
Miss
(mailing address)

WELL LOCATION:
sec. 34 T 3 N (S) R 3 E (W)
3 miles (distance) West (direction) of H. S. (nearest town)

WELL PURPOSE: Home
(home, irrigation, municipal, industrial)

WELL COMPLETION DATA:
(1) diameter (inches) 4
(2) total depth (feet) 246
(3) static water level (feet) 175 below above top of ground.
(4) casing Plastic (material), 236' (depth),
_____ (size) if telescope see back.
(5) screen 10' (length), 236' (depth to top)
4" (size), Plastic (material)
(6) pump 3/4 (HP) 10 (yield gpm)
Elec. (type power)
(7) electric log No (yes or no)
_____ (organization running log)
(8) how well bottom plugged PVC Cap

DRILLERS REMARKS:

| description of formations encountered | from | to |
|---|---|---|
| Surface Soil | 0 | 20 |
| Med. Red Sand | 20 | 45 |
| Red clay | 45 | 80 |
| White clay | 80 | 115 |
| Med White Sand | 115 | 140 |
| Fine White Sand | 140 | 195 |
| White clay | 195 | 210 |
| White coarse Sand | 210 | 246 |

DEPT. OF NATURAL RESOURCES
BUREAU OF LAND & WATER RESOURCES
APR 24 1981
RECEIVED

If well telescopes please sketch and show depths.

GROUND LEVEL

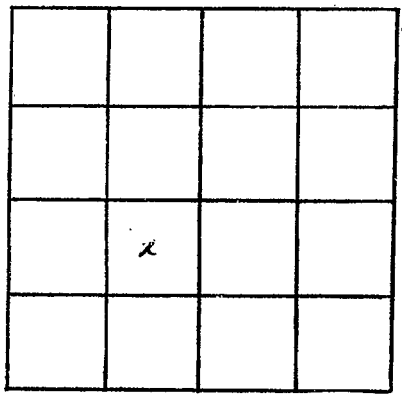


SECTION 34

Please indicate well location X.

ADDITIONAL INFORMATION

If more than one screen, show locations of each on sketch.