Marshall
N 2005
6-18-76

MISSISSIPPI
BOARD OF WATER COMMISSIONERS
416 North State Street
Jackson, Mississippi 39201

WATER WELL DRILLERS LOG

6-18 1976 Hicks Well Co. Marshal
date well completed — firm name — county well located

LANDOWNER: Corrine Echols
Rt. 3
Holly Springs, Miss.
(mailing address)

WELL LOCATION:
sec. 20 T 4 N (S) R 4 E (W)
12 miles W of Holly Springs
(distance) (direction) (nearest town)

WELL PURPOSE: Home
(home, irrigation, municipal, industrial)

WELL COMPLETION DATA:
(1) diameter (inches) 4"
(2) total depth (feet) 160
(3) static water level (feet) 80 below above top of ground.
(4) casing PVC (material), 160 (depth),
_____ (size) If telescope see back.
(5) screen 4' (length), 156 (depth to top)
4" (size), Gravel (material)
(6) pump 1/2 (HP) 10 (yield gpm)
220 (type power)
(7) electric log NO (yes or no)
_____ (organization running log)
(8) how well bottom plugged Cap

DRILLERS REMARKS:

description of formations encountered	from	to
Red Sand	0	30
Red Clay + Sand	30	90
Black Clay	90	115
White Sand	115	160

If well telescopes please sketch and show depths.

GROUND LEVEL

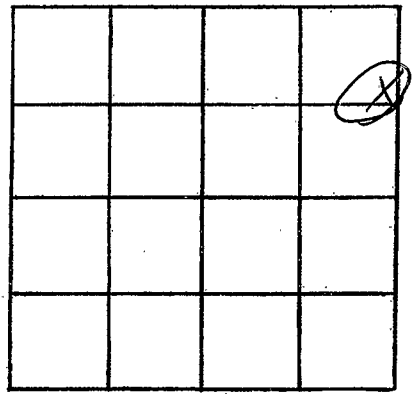

SECTION 20

Please indicate well location X.

ADDITIONAL INFORMATION

If more than one screen, show locations of each on sketch.