MISSISSIPPI DEPARTMENT OF NATURAL RESOURCES

Bureau of Land and Water Resources

P.O. Box 10631
Jackson, Mississippi 39209

WATER WELL DRILLERS LOG

COUNTY WELL LOCATED	Marshall
WELL NUMBER	N 20 6
CODED	3
DATE WELL COMPLETED	7-14-88
PERMIT NUMBER	
NAME OF DRILLING FIRM	HICKS WELL COMPANY P. O. BOX 157

NAME & MAILING ADDRESS OF LANDOWNER: Corner Grocery c/o John Echols Holly Springs, Miss. 38635

WELL LOCATION: SEC 18 TOWNSHIP 4 N RANGE 4 E

DISTANCE — Miles DIRECTION — NEAREST TOWN of Matthews Corner

OTHER LANDMARK

WELL PURPOSE: Home, Irrigation, Municipal, Industrial, Fish Pond, etc.: Gro. Store

PUMP DATA

PUMP TYPE (Circle One): Submersible, Turbine, Jet, Flowing Well, Other (Describe)

POWER TYPE (Circle One): Electric, Tractor, Diesel, Gasoline, Butane, Other (Describe)

Pump Capacity (GPM)	No. of Stages	Setting Depth
10	9	60 FT.

PUMP TEST

Well yielded _____ GPM with a drawdown of _____ ft. after _____ hours of pumping

WELL DATA

Well Depth	Casing Diameter (In.)	Casing Length (Ft.)
140	4	130
Type of Casing	**Hole Depth**	**Depth to Static Water Level**
PVC	140	40

TYPE OF COMPLETION: (Circle One or More): Gravel Packed, Underreamed, Telescoped, Natural Development, Open Hole, Other (Describe)

Top of Lap Pipe or Reduction in Casing FEET

IF TELESCOPED OR MORE THAN ONE SCREEN: USE BACK PAGE

LOG DATA

TYPE OF LOG RUN (Circle One): No Log Run, Electric, Gamma Ray, Density, Sonic, Neutron, Other (Describe)

Name of Organization Running Log

GEOLOGIC DATA (Office Use Only)

Surface Elev.	Geologic Unit	Unit Thickness	Depth to Top
Subs. SWL	Date	Analysis	Aquifer Test

Driller's Remarks

RECEIVED SEP 21 1988 Department of Natural Resources Bureau of Land & Water Resources

SCREEN DATA

Diameter - Inches	Length - Feet	Slot Size - Inches
4	10	.013
Screen Type	**Depth to Bottom - Feet**	
PVC	—	

DESCRIPTION OF FORMATIONS ENCOUNTERED	FROM	TO
Red Clay	0	15
Light Sand Sand	15	140

FORMATIONS (Continued)	FROM	TO

IF MORE SPACE IS NEEDED, USE BACK

If well telescopes please
sketch and show depths.

GROUND LEVEL

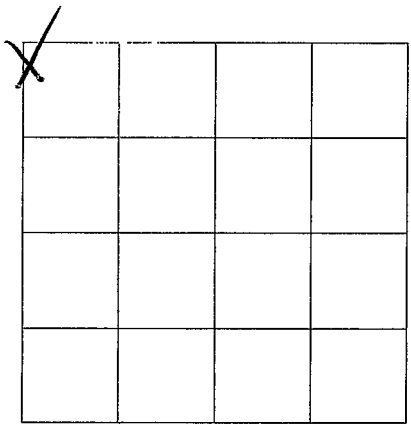

SECTION 18

Please indicate well location X.

ADDITIONAL INFORMATION

If more than one screen,
show location of each on sketch.