Marshall
O 2041

MISSISSIPPI DEPARTMENT OF NATURAL RESOURCES
Bureau of Land and Water Resources
Southport Mall
P.O. Box 10631
Jackson, Mississippi 39209

WATER WELL DRILLERS LOG

3 - 12 1983 R. L. Carpenter Marshall
date well completed — firm name — county well located

LANDOWNER: Frank Swoots
Holly Springs, Ms.
RFD
(mailing address)

WELL LOCATION:
sec. 12 T 4 N/S R 3 E/W
3/4 miles SW of H.S
(distance) (direction) (nearest town)

WELL PURPOSE: Home
(home, irrigation, municipal, industrial)

WELL COMPLETION DATA:
(1) diameter (inches) 4
(2) total depth (feet) 170
(3) static water level (feet) 100 below/above top of ground.
(4) casing Plastic (material), 160' (depth),
_____ (size) if telescope see back.
(5) screen 10' (length), 160' (depth to top)
4" (size), PVC (material)
(6) pump 1/2 (HP) 10 (yield gpm)
Elec. (type power)
(7) electric log No. (yes or no)
_____ (organization running log)
(8) how well bottom plugged PVC Cap

DRILLERS REMARKS:

description of formations encountered	from	to
Surface Soil	0	25
Med. Red Sand	25	52
Med. white Sand	52	75
White Clay	75	96
Fine white Sand	96	120
white Clay	120	135
white Coarse Sand	135	170

DEPT. OF NATURAL RESOURCES
BUREAU OF LAND & WATER RESOURCES
OCT 26 1984
RECEIVED

If well telescopes please sketch and show depths.

GROUND LEVEL

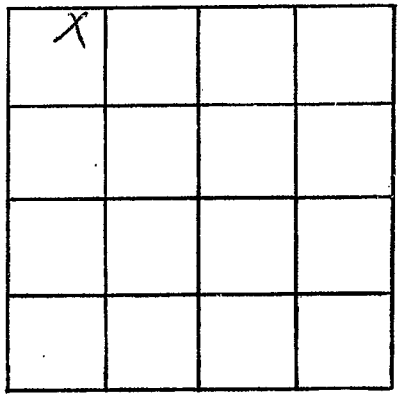

SECTION 12

Please indicate well location X.

ADDITIONAL INFORMATION

If more than one screen, show locations of each on sketch.