Marshall
P-25
6-1-71

MISSISSIPPI
BOARD OF WATER COMMISSIONERS
416 North State Street
Jackson, Mississippi 39201

CODED

WATER WELL DRILLERS LOG

6-1 19 71 — Robert W. Wilson — Marshall
date well completed — firm name — county well located

LANDOWNER: Leslie Anderson
Potts Camp
Miss.
(mailing address)

WELL LOCATION:
sec. 22 T 4 N (S) R 2 E (W)

_____ miles _____ of _____
(distance) (direction) (nearest town)

WELL PURPOSE: _____
(home, irrigation, municipal, industrial)

WELL COMPLETION DATA:

(1) diameter (inches) 4

(2) total depth (feet) 101

(3) static water level (feet) 20 below above top of ground.

(4) casing Plastic (material), 97 (depth),
4 (size) if telescope see back.

(5) screen 4 (length), 97 (depth to top)
4 (size), Gravel Pack (material)

(6) pump 3/4 (HP) 10 GPM (yield gpm)
Electric (type power)

(7) electric log — (yes or no)

_____ (organization running log)

(8) how well bottom plugged 4" Plastic Cap

DRILLERS REMARKS: _____

description of formations encountered	from	to
Red Clay Red Sand	0	20
Red Sand	20	101

SEP 7 1971
MISS. BD. OF WATER COMM.

If well telescopes please sketch and show depths.

GROUND LEVEL

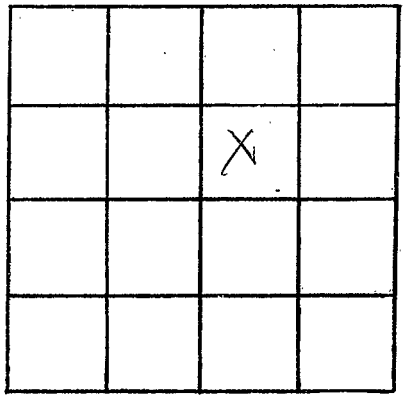

SECTION 22

Please indicate well location X.

ADDITIONAL INFORMATION

If more than one screen, show locations of each on sketch.