MARSHALL
P 2032
6-1-79

MISSISSIPPI
BOARD OF WATER COMMISSIONERS
416 North State Street
Jackson, Mississippi 39201

WATER WELL DRILLERS LOG

6-1 19 79 Hicks Well Co Marshall
date well completed — firm name — county well located

LANDOWNER: Patricial Isom
Holly Springs, Miss
(mailing address)

WELL LOCATION:
sec. 13 T 4 N (S) R 2 E (W)
3 (distance) miles N (direction) of Lake Center (nearest town)

WELL PURPOSE: home
(home, irrigation, municipal, industrial)

WELL COMPLETION DATA:
(1) diameter (inches) 4 in
(2) total depth (feet) 230
(3) static water level (feet) _____ below above top of ground.
(4) casing 2 Plastic (material), 230 (depth),
_____ (size) if telescope see back.
(5) screen 7 ft (length), 223 (depth to top)
4 in (size), Plastic (material)
(6) pump 1/2 (HP) 10 (yield gpm)
220 (type power)
(7) electric log No (yes or no)
_____ (organization running log)
(8) how well bottom plugged Cap

DRILLERS REMARKS:

description of formations encountered	from	to
Red Clay	0	20
Red Sand & Clay	20	90
Red Sand	90	160
White Sand	160	230

Miss. Board of Water Comm.
JUL 12 1979
RECEIVED

If well telescopes please sketch and show depths.

GROUND LEVEL

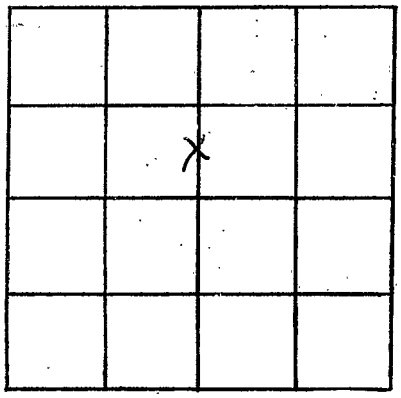

SECTION 13

Please indicate well location X.

ADDITIONAL INFORMATION

If more than one screen, show locations of each on sketch.