Marshall
P 2038
11-14-79

MISSISSIPPI
BOARD OF WATER COMMISSIONERS
416 North State Street
Jackson, Mississippi 39201

WATER WELL DRILLERS LOG

11-14 1979 — date well completed
Robert W. Wilson — firm name
Marshall ~~Benton~~ — county well located

LANDOWNER: Richard + Lucille Brooks
Rt. 2 Box 130 Holly Springs, Ms
(mailing address)

WELL LOCATION:
sec 16 T 4 N (S) R 2 E (W)

_____ miles _____ of _____
(distance) (direction) (nearest town)

WELL PURPOSE: _____
(home, irrigation, municipal, industrial)

WELL COMPLETION DATA:

(1) diameter (inches) 4
(2) total depth (feet) 120
(3) static water level (feet) 65 below above top of ground.
(4) casing _____ (material), 110 (depth),
_____ (size) if telescope see back.
(5) screen 10 (length), _____ (depth to top)
_____ (size), gravel packed (material)
(6) pump 3/4 (HP) 10 (yield gpm)
electric (type power)
(7) electric log _____ (yes or no)
_____ (organization running log)
(8) how well bottom plugged 4" plastic plug

DRILLERS REMARKS: _____

description of formations encountered	from	to
Red Clay & Red Sand	0	30
Red Sand Blue clay & gray	30	60
white clay & white sand	60	90
white sand	90	120

DEPT. OF NATURAL RESOURCES
BUREAU OF LAND & WATER RESOURCES
JAN 7 1980
RECEIVED

If well telescopes please sketch and show depths.

GROUND LEVEL

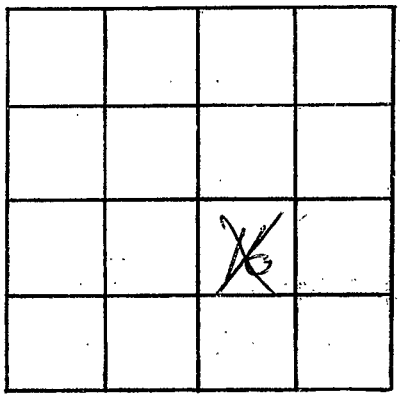

SECTION 16

Please indicate well location X.

ADDITIONAL INFORMATION

If more than one screen, show locations of each on sketch.