MISSISSIPPI DEPARTMENT OF NATURAL RESOURCES

Bureau of Land and Water Resources

P.O. Box 10631
Jackson, Mississippi 39209
WATER WELL DRILLERS LOG

COUNTY WELL LOCATED: Marshall	
WELL NUMBER: P 2086	CODED:
DATE WELL COMPLETED: 4-10-87	
PERMIT NUMBER	
NAME OF DRILLING FIRM: HICKS WELL COMPANY	
RT. 1 - BOX 157	

NAME & MAILING ADDRESS OF LANDOWNER: SARATOBIA, MISS.

Eugene Washington
Holly Springs, MS
38635

WELL LOCATION: SEC 3 TOWNSHIP 4 N S RANGE 2 E W

DISTANCE 2 Miles DIRECTION E of NEAREST TOWN Holly Springs

OTHER LANDMARK

WELL PURPOSE: (Home) Irrigation, Municipal, Industrial, Fish Pond, etc.

PUMP DATA

PUMP TYPE (Circle One): (Submersible) Turbine, Jet Flowing Well, Other (Describe)

POWER TYPE (Circle One): (Electric) Tractor, Diesel, Gasoline, Butane, Other (Describe)

Pump Capacity (GPM)	No. of Stages	Setting Depth
10	7	160 FT.

PUMP TEST

Well yielded _____ GPM with a drawdown of _____ ft. after _____ hours of pumping

WELL DATA

Well Depth	Casing Diameter (In.)	Casing Length (Ft.)
200'	4"	190'
Type of Casing	**Hole Depth**	**Depth to Static Water Level**
PVC	200'	140'

TYPE OF COMPLETION: (Circle One or More): Gravel Packed, Underreamed, Telescoped, Natural Development, Open Hole, Other (Describe) PVC Cap

Top of Lap Pipe or Reduction in Casing FEET

IF TELESCOPED OR MORE THAN ONE SCREEN: USE BACK PAGE

LOG DATA

TYPE OF LOG RUN (Circle One): No Log Run, Electric, Gamma Ray, Density, Sonic, Neutron, Other (Describe)

Name of Organization Running Log

GEOLOGIC DATA (Office Use Only)

Surface Elev.	Geologic Unit	Unit Thickness	Depth to Top
Subs. SWL	Date	Analysis	Aquifer Test

Driller's Remarks

SCREEN DATA

Diameter - Inches	Length - Feet	Slot Size - Inches
4"	10'	.013
Screen Type	**Depth to Bottom - Feet**	
PVC	200'	

DESCRIPTION OF FORMATIONS ENCOUNTERED	FROM	TO	FORMATIONS (Continued)	FROM	TO
Red Sand	0	30			
Clay	30	60			
White Sand	60	200			
			IF MORE SPACE IS NEEDED, USE BACK		

If well telescopes please
sketch and show depths.

GROUND LEVEL

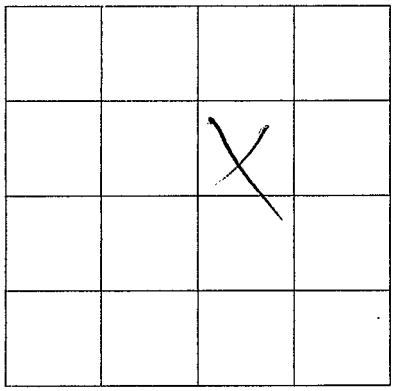

SECTION 3

Please indicate well location X.

ADDITIONAL INFORMATION

If more than one screen,
show location of each on sketch.