MARSHALL
S 19
11-3-71

MISSISSIPPI
BOARD OF WATER COMMISSIONERS
416 North State Street
Jackson, Mississippi 39201

WATER WELL DRILLERS LOG

CODED

11/3/ 1971 G. and H. Well Co, Marshall
date well completed — firm name — county well located

LANDOWNER: Jackie Richard

Holly Springs, Mississippi
(mailing address)

WELL LOCATION:
sec. 7 T. 3 N R. 3 E
8 miles SW of Holly Springs
(distance) (direction) (nearest town)

WELL PURPOSE: Home
(home, irrigation, municipal, industrial)

WELL COMPLETION DATA:

(1) diameter (inches) 4 Inched

(2) total depth (feet) 285

(3) static water level (feet) 150 below ~~above~~ top of ground.

(4) casing Plastic (material), 285 (depth),
_____ (size) if telescope see back.

(5) screen 5 ft. (length), 278 ft. (depth to top)
4 in. (size), Gravel (material)

(6) pump 3/4 (HP) 5 GOM (yield gpm)
Electric (type power)

(7) electric log No (yes or no)
_____ (organization running log)

(8) how well bottom plugged Cap

DRILLERS REMARKS: _____

description of formations encountered	from	to
Red sand	1	15
" "	15	25
" "	25	35
" "	35	45
Course Red and White Sand	45	55
White and Red Sand	55	65
" " " "	65	75
" " " "	75	85
Course White Sand	85	95
" " "	95	105
" " "	105	115
" " "	115	125
White Sand	125	135
" "	135	145
" "	145	155
" "	155	165
White Sand Clay	165	175
White Sand	175	185
" "	185	195
" "	195	205
White Clay Sand Rock	205	215
Black Clay Sand	215	225
White and Black Clay & Sand	225	235
" " " " "	235	245
" " " " "	245	255
White Sand	255	265
" "	265	275
" "	275	285

CODED

JAN 6 1972

MISS. BD. OF WATER COMM.

If well telescopes please sketch and show depths.

GROUND LEVEL

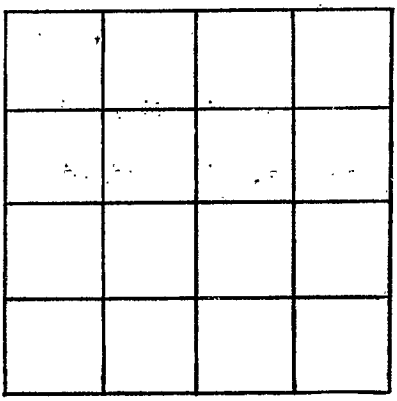

SECTION _____

Please indicate well location X.

ADDITIONAL INFORMATION

If more than one screen, show locations of each on sketch.