MARSHALL
S 2016
10-29-80

MISSISSIPPI
BOARD OF WATER COMMISSIONERS
416 North State Street
Jackson, Mississippi 39201

WATER WELL DRILLERS LOG

10-29 19 80 — date well completed
Hicks Well Co — firm name
Marshall — county well located

LANDOWNER: Ruthie M. Howell
Rt. 5
Holly Springs, Ms. 38635
(mailing address)

WELL LOCATION:
sec. 7 T. 5 N (S) R. 3 E (W)
— miles — of Holana
(distance) (direction) (nearest town)

WELL PURPOSE: Home
(home, irrigation, municipal, industrial)

WELL COMPLETION DATA:

(1) diameter (inches) 4
(2) total depth (feet) 245
(3) static water level (feet) 180 below above top of ground.
(4) casing PVC (material), 245 (depth),
— (size) if telescope see back.
(5) screen 12 (length), 233 (depth to top)
4" (size), PVC & Gravel (material)
(6) pump 3/4 (HP) 10 (yield gpm)
220 V (type power)
(7) electric log No (yes or no)
(organization running log)
(8) how well bottom plugged Cap

DRILLERS REMARKS:

description of formations encountered	from	to
Red Clay	0	15
Clay & Sand	15	175
White Sand	175	245

DEPT. OF NATURAL RESOURCES
BUREAU OF LAND & WATER RESOURCES
DEC - 3 1980
RECEIVED

If well telescopes please sketch and show depths.

GROUND LEVEL

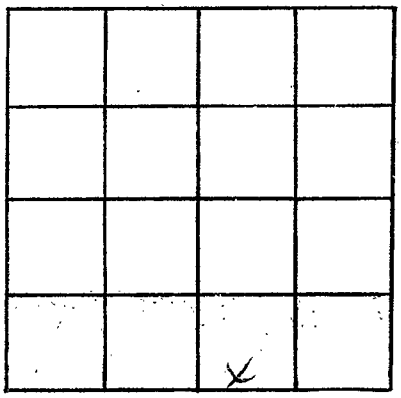

SECTION 7

Please indicate well location X.

ADDITIONAL INFORMATION

If more than one screen, show locations of each on sketch.