MARSHALL
T 11
10-16-71

MISSISSIPPI BOARD OF WATER COMMISSIONERS
416 North State Street
Jackson, Mississippi 39201

CODED

WATER WELL DRILLERS LOG

10/16/71 (date well completed) 19 G and H. Well Company (firm name) Marshal (county well located)

LANDOWNER: Eddie Frank Ford

Waterford, Mississippi

(mailing address)

WELL LOCATION:

sec. 30 T 5 N (S) R 2 E (W)

3 (distance) miles SE (direction) of Waterford (nearest town)

WELL PURPOSE: Home (home, irrigation, municipal, industrial)

WELL COMPLETION DATA:

(1) diameter (inches) 4 Inches

(2) total depth (feet) 155

(3) static water level (feet) 125 below above top of ground.

(4) casing Plastic (material), 155 (depth),

(size) if telescope see back.

(5) screen 5 ft. (length), 6 ft (depth to top)

4 in (size), Gravel (material)

(6) pump 3/4 (HP) 5 GPM (yield gpm)

Electric (type power)

(7) electric log No (yes or no)

(organization running log)

(8) how well bottom plugged Cap

DRILLERS REMARKS:

description of formations encountered	from	to
Red Clay	1	15
Red sandy Clay	15	25
Red sand	25	35
" "	35	45
" "	45	55
" "	55	65
" "	65	75
" "	75	85
" "	85	95
White Sand	95	105
" "	105	115
" "	115	125
" "	125	135
" "	135	145
" "	145	155

CODED

OCT 18 1971

MISS. BD. OF WATER COMM

If well telescopes please sketch and show depths.

GROUND LEVEL

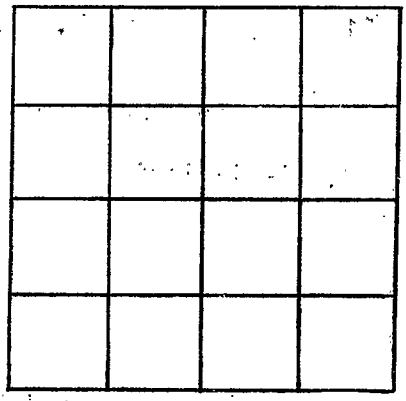

SECTION _____

Please indicate well location X.

ADDITIONAL INFORMATION

If more than one screen, show locations of each on sketch.