Need Sec. #

MARSHALL
T 2001
6/2/76

MISSISSIPPI
BOARD OF WATER COMMISSIONERS
416 North State Street
15F Jackson, Mississippi 39201

WATER WELL DRILLERS LOG

6/2/76 19 Medlin Well Drilling Marshall
date well completed — firm name — county well located

LANDOWNER: James Bailey

Potts Camp Miss.
(mailing address)

WELL LOCATION:
sec. ___ T 5 N (S) R 2 E (W)
5 miles S.W. of Potts Camp
(distance) (direction) (nearest town)

WELL PURPOSE: Home
(home, irrigation, municipal, industrial)

WELL COMPLETION DATA:
(1) diameter (inches) 4
(2) total depth (feet) 750
(3) static water level (feet) 130 below above top of ground.
(4) casing P.V.C (material), 380 (depth),
___ (size) if telescope see back.
(5) screen ___ (length), ___ (depth to top)
___ (size), ___ (material)
(6) pump 1/2 (HP) 8 (yield gpm)
Elec. (type power)
(7) electric log ___ (yes or no)
___ (organization running log)
(8) how well bottom plugged ___

DRILLERS REMARKS: ___

description of formations encountered	from	to
Clay	0	60
Sand Clay Mixed	60	200
Clay	200	330
Blue Clay	330	700
Sand + Rock	700	750

RECEIVED
JUL 28 1976
MISS. BD. OF WATER COMM.

If well telescopes please sketch and show depths.

GROUND LEVEL

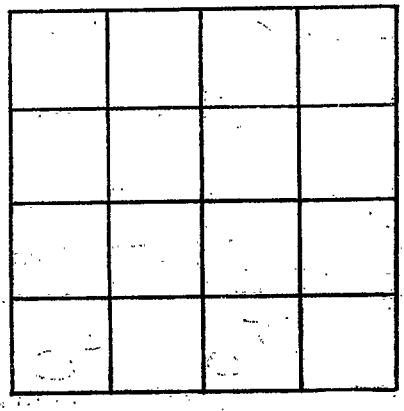

SECTION _____

Please indicate well location X.

ADDITIONAL INFORMATION

If more than one screen, show locations of each on sketch.