MISSISSIPPI DEPARTMENT OF NATURAL RESOURCES

Bureau of Land and Water Resources

P.O. Box 10631
Jackson, Mississippi 39209
WATER WELL DRILLERS LOG

COUNTY WELL LOCATED: Marshall	
WELL NUMBER: 5	CODED:
42016	PERMIT NUMBER:
DATE WELL COMPLETED: 4-11-89	NAME OF DRILLING FIRM: Medlin Well Drilling

NAME & MAILING ADDRESS OF LANDOWNER
Kerry Moore
Potts Camp, MS.

WELL LOCATION: SEC 6 TOWNSHIP 5 N (S) RANGE 3 E (W)

DISTANCE 4 Miles DIRECTION West NEAREST TOWN of Potts Camp

OTHER LANDMARK
Tennessee Hill

WELL PURPOSE: Home, Irrigation, Municipal, Industrial, Fish Pond, etc.

PUMP DATA

PUMP TYPE (Circle One): Submersible, Turbine, Jet, Flowing Well, Other (Describe) _____

POWER TYPE (Circle One): Electric, Tractor, Diesel, Gasoline, Butane, Other (Describe) _____ H/P _____

Pump Capacity (GPM)	No. of Stages	Setting Depth
8	8	210' FT.

PUMP TEST
Well yielded 9 GPM with a drawdown of 1' ft. after 24 hours of pumping

WELL DATA

Well Depth	Casing Diameter (In.)	Casing Length (Ft.)
980'	4"	300'

Type of Casing	Hole Depth	Depth to Static Water Level
PVC	980'	170'

TYPE OF COMPLETION: (Circle One or More): Gravel Packed, Underreamed, Telescoped, Natural Development, Open Hole, Other (Describe) 4x6 shell catcher

Top of Lap Pipe or Reduction in Casing FEET

IF TELESCOPED OR MORE THAN ONE SCREEN: USE BACK PAGE

LOG DATA

TYPE OF LOG RUN (Circle One): No Log Run, Electric, Gamma Ray, Density, Sonic, Neutron, Other (Describe) _____

Name of Organization Running Log

GEOLOGIC DATA (Office Use Only)

Surface Elev.	Geologic Unit	Unit Thickness	Depth to Top
Subs. SWL	Date	Analysis	Aquifer Test

Driller's Remarks
Stayed in same yard 3 mo.+ Have not gotten a good well yet.

SCREEN DATA

Diameter - Inches	Length - Feet	Slot Size - Inches
Screen Type		Depth to Bottom - Feet

DESCRIPTION OF FORMATIONS ENCOUNTERED	FROM	TO	FORMATIONS (Continued)	FROM	TO
			IF MORE SPACE IS NEEDED, USE BACK		

RECEIVED
SEP 28 1989
Department of Natural Resources
Bureau of Land & Water Resources

If well telescopes please
sketch and show depths.

GROUND LEVEL

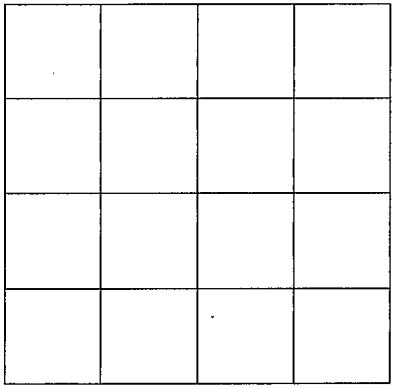

SECTION _____

Please indicate well location X.

ADDITIONAL INFORMATION

If more than one screen,
show location of each on sketch.