Marshall
429

MISSISSIPPI DEPARTMENT OF NATURAL RESOURCES
Bureau of Land and Water Resources
Southport Mall
P.O. Box 10631
Jackson, Mississippi 39209

CODED

WATER WELL DRILLERS LOG

10·25·85 19 Medlin Water Well Marshall
date well completed — firm name — county well located

LANDOWNER: Joe Cooper & Sons Farm
Potts Comp, MS. Bethlehem
(mailing address)

WELL LOCATION:
sec. 5 T 6 N (S) R 1 E (W)
7 miles South of Potts Comp
(distance) (direction) (nearest town)

WELL PURPOSE:
(home, irrigation, municipal, industrial)

WELL COMPLETION DATA:
(1) diameter (inches) 4"
(2) total depth (feet) 880'
(3) static water level (feet) 320' below above top of ground.
(4) casing PVC, 480'
(material), (depth),
_____ if telescope see back.
(size)
(5) screen _____, _____
(length), (depth to top)
_____, _____
(size), (material)
(6) pump 1½ 23
(HP) (yield gpm)
Electric
(type power)
(7) electric log _____
(yes or no)
_____
(organization running log)
(8) how well bottom plugged _____

DRILLERS REMARKS: _____

description of formations encountered	from	to
Top soil	0-	80
Limerock	80-	195
Shell & Limerock	195-	310
Rock & Limerock	310-	490
Rock & Sand	490-	680
Rock & Rock & Rock	680-	775
Aquafer	775	880

CODED

RECEIVED
MAR 3 - 1986
Department of Natural Resources
Bureau of Land & Water Resources

If well telescopes please sketch and show depths.

GROUND LEVEL

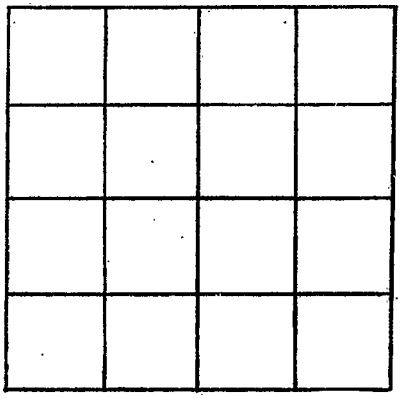

SECTION _____

Please indicate well location X.

ADDITIONAL INFORMATION

If more than one screen, show locations of each on sketch.