Marshall
Y 2009
7-18-80

MISSISSIPPI
BOARD OF WATER COMMISSIONERS
416 North State Street
Jackson, Mississippi 39201

WATER WELL DRILLERS LOG

July 18 19 80 J T Medlin Marshall
date well completed | firm name | county well located

LANDOWNER IVAN OWENS
Potts Camp
HW 349
(mailing address)

WELL LOCATION:
sec. 7 T 2 N/S R 1 E/W
5 miles S.W. of Bethlehem
(distance) (direction) (nearest town)

WELL PURPOSE: (home, irrigation, municipal, industrial)

WELL COMPLETION DATA:
(1) diameter (inches) 4"
(2) total depth (feet) 260
(3) static water level (feet) 45 below/above top of ground.
(4) casing P (material), 340 (depth),
2 (size) if telescope see back.
(5) screen 100 (length), 660 (depth to top)
2 (size), P (material)
(6) pump 1/2 (HP) 12 (yield gpm)
E (type power)
(7) electric log _____ (yes or no)
_____ (organization running log)
(8) how well bottom plugged Cap

DRILLERS REMARKS: _____

description of formations encountered	from	to
Clay	0	260
Sand	260	290
Clay	290	610
Sock & sand	610	780

DEPT. OF NATURAL RESOURCES
BUREAU OF LAND & WATER RESOURCES
AUG 25 1980
RECEIVED

If well telescopes please sketch and show depths.

GROUND LEVEL

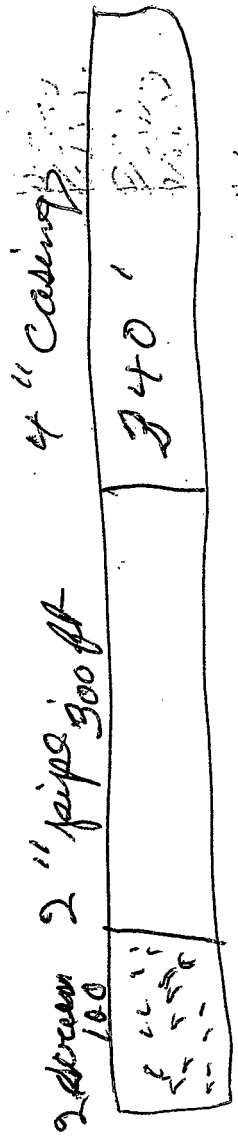

If more than one screen, show locations of each on sketch.

SECTION ____

Please indicate well location X.

ADDITIONAL INFORMATION