

WATER WELL DRILLERS LOG

Herndon Well & Supply Co.

SHANNON, MISS.

B  
7-19-60

Date: July 15, 1960, Driller: \_\_\_\_\_ County: Monroe  
(Name)


	Description & Color of Materials Sand, Clay, Red Clay, Shell, etc.	Thick- ness Feet	Depth Feet
(1) Owner of Land: <u>Mary Jane Gray</u> (Name) <u>Nettleton, Miss.</u> (Address)	<u>Sand &amp; Clay</u>		<u>20</u>
(2) Location: _____ 1/4, _____ 1/4, Sec. _____ T _____ R _____ <u>2</u> miles <u>East</u> of <u>Nettleton</u> (distance) (direction) (Nearest Town)	<u>Blue Shale</u>		<u>40</u>
(3) Topography: <u>Flat</u> (Hilly) (Flat) (Level)	<u>Sand</u>		
(4) Purpose of Well: <u>Home Use</u> (Domestic Irrigation Municipal, Industrial, Other)	<u>Bottom</u>		<u>168</u>

Information upon completion of well:

- (1) Diameter 4 inches.
- (2) Total Depth 168 feet.
- (3) Water Level 60 feet below top of ground.
- (4) Cased to 21 ft. Size 4"
- (5) Screen: Size \_\_\_\_\_ Length \_\_\_\_\_
- (6) Were any formations sealed against pollution?  
X yes, \_\_\_\_\_ no.

If YES depth of formation: 25 ft.  
Why: Surface & Sand

Drillers Remarks: \_\_\_\_\_

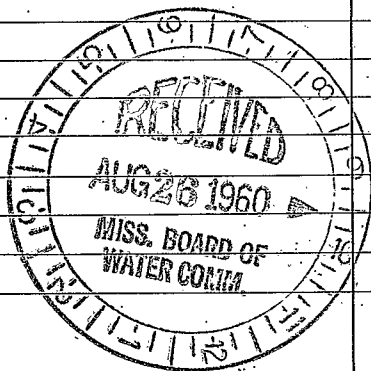

(Use Back Side)

Well No.




