

B48

CODED

WATER WELL DRILLERS LOG

10-17-60

Date: 10-17, 1960, Driller: W. J. REEVES & SON County MONROE

234-1 TURN RT ON BUNCH ST (Name) GOTO CH TR RT 2ND HO ON ICT.

(1) Owner of Land: JAMES CARNER (Name)

ABERDEEN, MISS- (Address)

HW 278 W 256 8713 SL NENE (2) Location: 1/4, 1/4, Sec. 32 T12R 7,

4 miles W of AMORY (distance) (direction) (Nearest Town)

(3) Topography: HILLY (Hilly) (Flat) (Level)

(4) Purpose of Well: DOMESTIC (Domestic Irrigation Municipal, Industrial, Other)

Information upon completion of well:

(1) Diameter 4 inches. NOT IN USE

(2) Total Depth 286 feet. ON WATER SYS

(3) Water Level 129 feet below top of ground.

(4) Cased to 32', Size 4"

(5) Screen: Size, Length

(6) Were any formations sealed against pollution?

yes, no.


If YES depth of formation

Why

Drillers Remarks:

Description & Color of Materials Sand, Clay, Red Clay, Shell, etc.	Thick- ness Feet	Depth Feet
RED CLAY	18	0
BLUE CLAY	127	18
BLUE SAND	12	145
SAND + CLAY STRKS	55	157
BLUE CLAY	14	212
BLUE SAND	42	226
BLUE CLAY	18	268

CODED

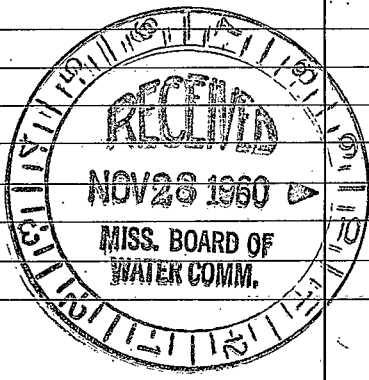

(Use Back Side)

Well No.






