

C 302

WATER WELL DRILLERS LOG

HERNDON WELL & SUPPLY CO.

8-17-61

Date: Aug 17, 1961, Driller: P. O. BOX 42 County Monroe

SHANNON, MISSISSIPPI

T.S. 3094264

(1) Owner of Land:	Description & Color of Materials Sand, Clay, Red Clay, Shell, etc.	Thick- ness Feet	Depth Feet
J. D. Sparks (Name)	Surface sand & clay		0
Mt. Auburn, Miss. (Address)	Blue rock		85
Location: 1/4, 1/4, Sec. 30 18 5 T. R. 7 E 5 miles North of Herndon, (distance) (direction) (Nearest Town)	Sand		90
(3) Topography: Flat (Hilly) (Flat) (Level)	Bottom		200
(4) Purpose of Well: Domestic (Domestic Irrigation Municipal, Industrial, Other)			

Information upon completion of well:


- (1) Diameter 4 inches.
- (2) Total Depth 200 feet.
- (3) Water Level 60 feet below top of ground.
- (4) Cased to 34' 8", Size 4"
- (5) Screen: Size \_\_\_\_\_, Length \_\_\_\_\_
- (6) Were any formations sealed against pollution?

yes, no.

If YES depth of formation 85'

Why surface & sand

Drillers Remarks:

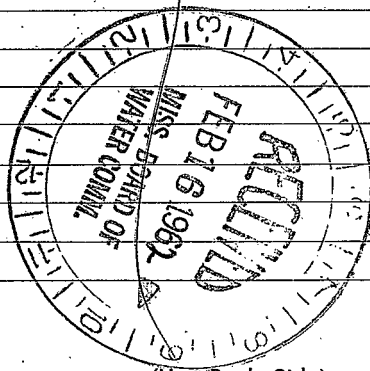

(Use Back Side)

Well No.




