Monroe
K 2010
5-26-76

136

MISSISSIPPI
BOARD OF WATER COMMISSIONERS
416 North State Street
Jackson, Mississippi 39201

WATER WELL DRILLERS LOG

Herman Homan Well & Supply, Inc.
P. O. Box 42
SHANNON, MISSISSIPPI 38868

firm name

5-26 1976
date well completed

Monroe
county well located

LANDOWNER: David Holliday (contd)
A 2 Okolona
(mailing address)

WELL LOCATION:
sec. 3 T 14 N/S R 6 E/W

4 miles N.E. of Gibson
(distance) (direction) (nearest town)

WELL PURPOSE: Home
(home, irrigation, municipal, industrial)

WELL COMPLETION DATA:

(1) diameter (inches) 4"
(2) total depth (feet) 360'
(3) static water level (feet) 10' below ~~above~~ top of ground.
(4) casing Steel (material), 42' (depth), 4" (size) if telescope see back.
(5) screen NO (length), (depth to top)
(size), (material)
(6) pump 1/2 (HP) 5 (yield gpm)
electric (type power)
(7) electric log NO (yes or no)
(organization running log)
(8) how well bottom plugged Open

DRILLERS REMARKS:

description of formations encountered	from	to
Surface sand	0	36
Blue clay	36	220
Sand	220	360
Bottom	360	

JUN - 8 1976
MISS. BOARD OF WATER COMMISSIONERS

If well telescopes please sketch and show depths.

GROUND LEVEL

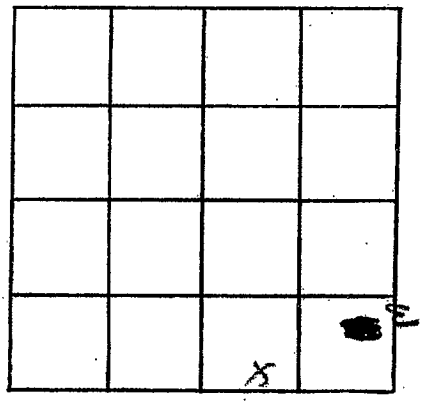

SECTION 3

Please indicate well location X.

ADDITIONAL INFORMATION

If more than one screen, show locations of each on sketch.