

MISSISSIPPI BOARD OF WATER COMMISSIONERS

MONROE
 TOWN

WATER WELL DRILLERS LOG

Date: 10-15-60, 1960, Driller: W. J. REEVES & SON County MONROE

(Name)

447-6,7

(1) Owner of Land: LUCILLE HOLGOMB
 (Name)

CATMAN, MISS.
 (Address)

(2) Location: 1/4, 1/4, Sec. 6 T14SR16,

2 miles W, of CATMAN,
 (distance) (direction) (Nearest Town)

(3) Topography: FLAT
 (Hilly) (Flat) (Level)

(4) Purpose of Well: DOMESTIC
 (Domestic Irrigation
 Municipal, Industrial, Other)

Description & Color of Materials
 Sand, Clay, Red Clay, Shell, etc.

Thick-
 ness
 Feet

Depth
 Feet

CLAY	17	0
WHITE SAND (FINE)	6	17
GRAVEL	3	23
CLAY	19	26
WHITE SAND	11	45
CLAY	18	56
WHITE SAND	14	74

Information upon completion of well:

(1) Diameter 4 inches.

(2) Total Depth 88' 9" feet.

(3) Water Level 20 feet below top of ground.

(4) Cased to 83' 9", Size 4"

(5) Screen: Size 4", Length 5'


(6) Were any formations sealed against pollution?

 yes, no.

If YES depth of formation

Why

Drillers Remarks:

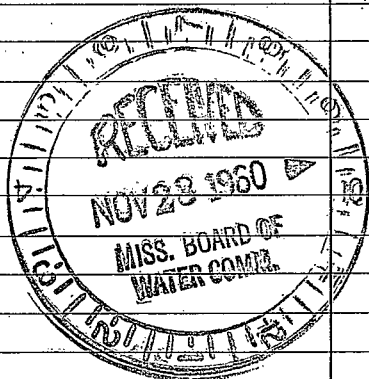

(Use Back Side)

Well No.















